

STATE OF KANSAS
STATE CORPORATION COMMISSION


Form CP-4

Give All Information Completely
Make Required Affidavit
Mail or Deliver Report to:
Conservation Division
State Corporation Commission
212 No. Market
Wichita, Kansas 67202

WELL PLUGGING RECORD

Ness County, Sec. 30 Twp. 16S Rge. (E) 26 (W)
Location as "NE/CNW/SW" or footage from lines C/SW SE
Lease Owner R. V. Lehner
Lease Name Dooner-Rolf Well No. 1
Office Address P. O. Box 398, Ness City, Kansas 67560
Character of Well (completed as Oil, Gas or Dry Hole) Dry Hole
Date well completed December 28 1970
Application for plugging filed December 28 1970
Application for plugging approved December 28 1970
Plugging commenced December 28 1970
Plugging completed December 28 1970
Reason for abandonment of well or producing formation Dry Hole

NORTH

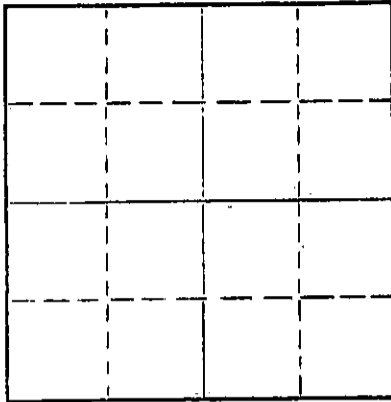

Locate well correctly on above
Section Plat

If a producing well is abandoned, date of last production _____ 19____
Was permission obtained from the Conservation Division or its agents before plugging was commenced? Yes

Name of Conservation Agent who supervised plugging of this well Leo Massey, Hays, Kansas
Producing formation _____ Depth to top _____ Bottom _____ Total Depth of Well 4630 Feet
Show depth and thickness of all water, oil and gas formations.

OIL, GAS OR WATER RECORDS

CASING RECORD

FORMATION	CONTENT	FROM	TO	SIZE	PUT IN	PULLED OUT
	8-5/8"	0	289.09'			

Describe in detail the manner in which the well was plugged, indicating where the mud fluid was placed and the method or methods used in introducing it into the hole. If cement or other plugs were used, state the character of same and depth placed, from _____ feet to _____ feet for each plug set.
Plugged hole as follows: Plugged at 800' with 70 sacks of common cement; plugged at 270' with 20 sacks of common cement; plugged at 40' with 10 sacks of common cement. Plug down at 9:15 A. M. December 28, 1970.

RECEIVED
STATE CORPORATION COMMISSION
DEC 31 1970
CONSERVATION DIVISION
Wichita, Kansas
12-31-70

(If additional description is necessary, use BACK of this sheet)


Name of Plugging Contractor Strata Drilling, Inc.
Address P. O. Box 355, Great Bend, Kansas 67530.

STATE OF KANSAS, COUNTY OF BARTON, ss.
Charles W. Steincamp (employee of owner) or (~~owner or operator~~) of the above-described well, being first duly sworn on oath, says: That I have knowledge of the facts, statements, and matters herein contained and the log of the above-described well as filed and that the same are true and correct. So help me God.

(Signature) Charles W. Steincamp
Charles W. Steincamp, President
P. O. Box 355, Great Bend, Kansas 67530
(Address)

Subscribed and sworn to before me this 29th day of December, 1970.

Elaine H. Taylor
Elaine H. Taylor Notary Public.
December 14, 1973

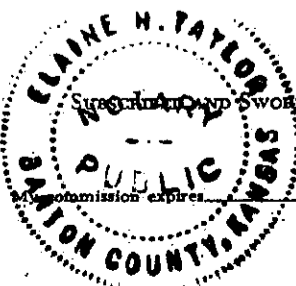

D R I L L E R S L O G

#1 Dooner-Rolf

CASING RECORD:
283.09' of new 8-5/8"
surface casing.

COMPANY: R. V. Lehner
CONTRACTOR: Strata Drilling, Inc.

DESCRIPTION: C/SW SE
Section 30-16S-26W
Ness County, Kansas

TOTAL DEPTH:
4630'

COMMENCED: December 16, 1970

ELEVATION: 2674' K. B.

COMPLETED: December 28, 1970

D. & A.

<u>FORMATION</u>	<u>FROM</u>	<u>TO</u>	<u>REMARKS</u>
Clay, Rock, Sand & Shale	0	306	Ran 283.09' of new 8-5/8" surface casing; set and cemented at 289.09' with 160 sacks of regular cement, 2% gel and 3% C. C. Plug down at 9:45 P. M. December 16, 1970.
Clay	306	496	
Shale, Shells, Sand & Red Bed	496	1420	
Red Bed & Shale	1420	1481	
#1 Anhydrite	1481	1511	
Red Bed	1511	1630	
Dakota Sand	1630	1824	
Red Bed & Shale	1824	2060	
Shale & Lime	2060	2086	
#2 Anhydrite	2086	2123	
Shale	2123	2408	
Shale & Lime	2408	3834	
Lime	3834	4222	
Lime w/Shale Streaks	4222	4280	
Lime & Shale	4280	4436	
Lime	4436	4465	
Lime & Shale	4465	4490	
Lime	4490	4545	
Cherty Lime & Shale	4545	4596	
Chert, Lime & Shale	4596	4630	

RECEIVED
STATE CORPORATION COMMISSION
DEC 31 1970
CONSERVATION DIVISION
Wichita, Kansas

ROTARY TOTAL DEPTH: 4630'

D. & A.

Plugged hole as follows: Plugged at 800' with 70 sacks of common cement; plugged at 270' with 20 sacks of common cement; plugged at 40' with 10 sacks of common cement. Plug down at 9:15 A. M. December 28, 1970.

STATE OF KANSAS)
) ss.
COUNTY OF BARTON)

I certify that this is a true and correct copy of the above log to the best of my knowledge.

STRATA DRILLING, INC.

Charles W. Steincamp
Charles W. Steincamp, President

Subscribed and sworn to before me this 29th day of December, 1970.

My Commission Expires:
December 14, 1973

Elaine H. Taylor
Elaine H. Taylor, Notary Public

