

API NUMBER 15-135-19075 0000

LEASE NAME Peters

WELL NUMBER A-1

 Ft. from S Section Line

 Ft. from E Section Line

SEC. 36 TWP. 16S RGE. 26W (E) or (W)

COUNTY Ness

Date Well Completed

Plugging Commenced 7-2-90

Plugging Completed 7-6-90

TYPE OR PRINT
 NOTICE: Fill out completely
 and return to Cons. Div.
 office within 30 days.

LEASE OPERATOR Phillips Petroleum Company

ADDRESS Rt #3 Box 20-A Great Bend, KS. 67530

PHONE#(316) 793-8421 OPERATORS LICENSE NO. 5229

Character of Well Oil

(Oil, Gas, D&A, SWD, Input, Water Supply Well)

The plugging proposal was approved on (date)

by (KCC District Agent's Name).

Is ACO-1 filed? If not, is well log attached?

Producing Formation Depth to Top Bottom T.D. 4504'

Show depth and thickness of all water, oil and gas formations.

OIL, GAS OR WATER RECORDS

CASING RECORD

Formation	Content	From	To	Size	Put In	Pulled out
				8 5/8"	242'	none
				5 1/2"	4483'	1629

Describe in detail the manner in which the well was plugged, indicating where the mud fluid was placed and the method or methods used in introducing it into the hole. If cement or other plugs were used, state the character of same and depth placed, from feet to feet each set.
Sanded bottom to 4430' ran 5 sacks cement, shot pipe @2000'
1629'. Mixed 300# hulls, 15 sacks gel, 100# hulls, 175 sacks
cement. Max pressure 400# Shut in 100#. 60/40 6% gel.

(If additional description is necessary, use BACK of this form.)

Name of Plugging Contractor KELSO CASING PULLING, INC. License No. 6050

Address P.O. Box 347 Chase, Kansas 67524

NAME OF PARTY RESPONSIBLE FOR PLUGGING FEES: Phillips Petroleum Company

STATE OF Kansas COUNTY OF Rice, ss.

R. Darrell Kelso

(Employee of Operator Phillips Petroleum Company) of Wichita, Kansas

above-described well, being first duly sworn on oath, says: That I have knowledge of the facts, statements, and matters herein contained and the log of the above-described well as filed that the same are true and correct, so help me God.


(Signature) *R. Darrell Kelso*

(Address) P.O. Box 347 Chase, KS. 67524

SUBSCRIBED AND SWORN TO before me this 26 day of July, 19 90


Irene Herzberg
 Notary Public

My Commission Expires:

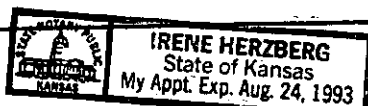

WELL SCHEMATIC

GL 2569'
 DF 2571'
 KB 2574'
 PBTD _____
 TD 4504'

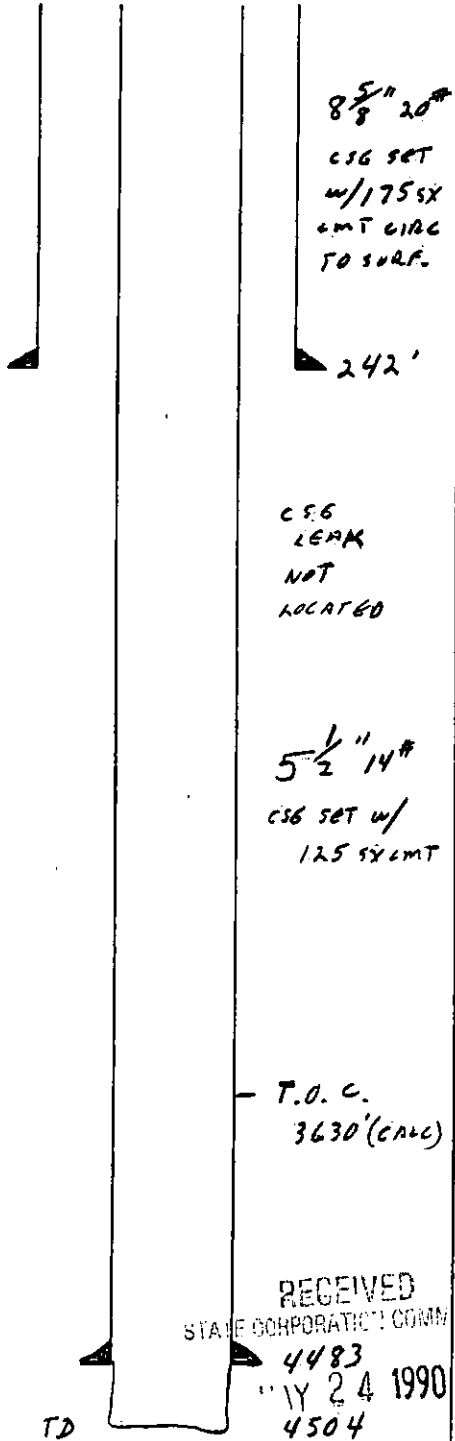

15135190750000

WELL DATA

WELL PETERS "A" No. 1 STATUS SD IMI.
 LOCATION C SE NE
SEC 36-T16S-R26W
NESS COUNTY, KS SW ARNOLD FIELD
 SPUD 3-22-64
 COMPLETED 4-1-64
 IP 120 BOPD 4/4/64

CASING	OD	WT	GRADE	FROM	TO
12 1/4" Hole	8 5/8"	20#	SET W/175 SYCMT SURF		242' CI
7 7/8" Hole	5 1/2"	14#	SET W/125 SYCMT @ TOE		4483' / 3630' (CALC)

PERFS.	ZONE	TYPE	INTERVAL	SPF
OPEN HOLE	MISSISSIPPI		4483-4504'	

LOGS	TYPE	DATE	COMPANY	FOOTAGE
	GR-NEWSPR GUARD	4/64	GREAT LAKES	
	NO COPY AVAILABLE			

WELL TEST	DATE	BOPD	MCFGPD	BWPD
FORMATIONS	BASEM ANHYDRITE	1335'		
	STONE CARB ANHYDRITE	1924'		
	HEARNER	3832'		
	TORONTO	3855'		
	LANSING	3874'		
	BASE KANSASITY	4178'		
	FT. SCOTT	4380'		
	CONGLOMERATE	4454'		
	MISS. DAL.	4480'		
	RTD	4500'		

HISTORY

4-5-64 ACIDIZE w/ 2500 GAL 15% HCL
 6-2-64 DEEPEMED TO 4504', 4000 GAL 15% HCL
 9-76 CLEANOUT TPTA w/ DUMP BALLER
 5-86 CLEANOUT & ACIDIZE w/ 2000 GAL 15% HCL
 8-8-89 ACIDIZE w/ 1000 GAL 15% HCL ACID
 8-10-89 ACIDIZE w/ 100 GAL 15% MUD ACID
 8-11-89 WELL SHUT DOWN

PREPARED BY: CON DAR DIVISION
 Wichita, Kansas
 DATE: 5/17/90

RECEIVED
 STATE CORPORATE COMM
 4483
 MAY 24 1990
 4504

T.O.C.
 3630' (CALC)

5 1/2" 14#
 CSB SET w/
 125 SYCMT

CSB
 LEAK
 NOT
 LOCATED

8 5/8" 20#
 CSB SET
 w/175 SY
 CMT CIRC
 TO SURF.
 242'