


Give All Information Completely  
Make Required Affidavit  
Mail or Deliver Report to:  
Conservation Division  
State Corporation Commission  
P. O. Box 17027  
Wichita, Kansas 67217  
NORTH

WELL PLUGGING RECORD

Ness County, Sec. 35 Twp. 16 Rge. (E) 26 (W)  
Location as "NE/CNW/SW" or footage from lines NE NE NW  
Lease Owner Wesselowski-Devlin Oil Operations  
Lease Name Hopkins Well No. 1  
Office Address W Suite 3, Sutton Place, Wichita, Ks. 67202  
Character of Well (completed as Oil, Gas or Dry Hole) Dry hole  
Date well completed 5-19 19 81  
Application for plugging filed 5-22 19 81  
Application for plugging approved 5-22 19 81  
Plugging commenced 5-19 19 81  
Plugging completed 5-19 19 81  
Reason for abandonment of well or producing formation dry hole

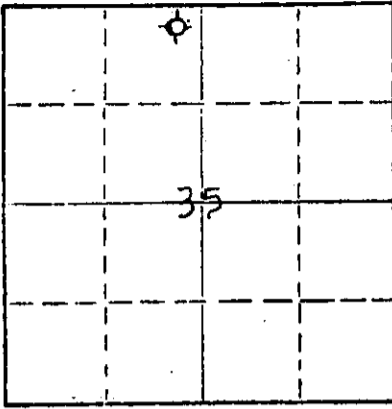

Locate well correctly on above Section Plat

If a producing well is abandoned, date of last production 19  
Was permission obtained from the Conservation Division or its agents before plugging was commenced? Yes

Name of Conservation Agent who supervised plugging of this well Marion Schmidt  
Producing formation \_\_\_\_\_ Depth to top \_\_\_\_\_ Bottom \_\_\_\_\_ Total Depth of Well 4592 Feet  
Show depth and thickness of all water, oil and gas formations.

OIL, GAS OR WATER RECORDS

CASING RECORD

FORMATION	CONTENT	FROM	TO	SIZE	PUT IN	PULLED OUT
		0	325	8 5/8"	325	

Describe in detail the manner in which the well was plugged, indicating where the mud fluid was placed and the method or methods used in introducing it into the hole. If cement or other plugs were used, state the character of same and depth placed, from \_\_\_\_\_ feet to \_\_\_\_\_ feet for each plug set.

plugged through drill pipe @ 1200' w/65 SX.  
" " " " " 330' w/30 SX.  
" " " " " 40' w/10 SX.

RECEIVED  
STATE CORPORATION COMMISSION  
MAY - 2 1981  
6-1-81  
CONSERVATION DIVISION  
Wichita, Kansas

(If additional description is necessary, use BACK of this sheet)

Name of Plugging Contractor Warrior Drilling Co.  
Address 905 Century Plaza, Wichita, Ks. 67202

STATE OF KANSAS, COUNTY OF SEDGWICK ss.

Thomas G. Wesselowski (employee or owner or operator) of the above-described well, being first duly sworn on oath, says: That I have knowledge of the facts, statements, and matters herein contained and the log of the above-described well as filed and that the same are true and correct. So help me God.


(Signature) Thomas Wesselowski  
Suite 3, Sutton Place Wichita, Ks. 67202  
(Address)

SUBSCRIBED AND SWORN TO before me this 26th day of May, 19 81

Francis E. Barham  
Notary Public.

My commission expires April 20, 1983

Francis E. Barham

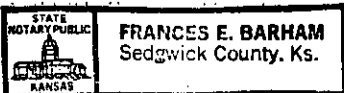

WELL LOG

15-135-22021-0000

#1 Hopkins  
NE NE NW Sec. 35-16S-26W  
Ness County, Kansas

OPERATOR: Wesselowski-Devlin Oil Operations  
CONTRACTOR: Warrior Drilling, Inc.  
COMMENCED: May 12, 1981  
COMPLETED: May 19, 1981

8 5/8 @ 325' w/190 sx

0	20	Rock
20	330	Surface Clay
330	1745	Sand & Clay
1745	2008	Sand & Shale
2008	2042	Anhydrite
2042	2110	Shale
2110	4165	Shale & Lime
4165	4490	Lime & Shale
4490	4592	Lime
4592		RTD

RECEIVED  
STATE CORPORATION COMMISSION  
MAY 29 1981  
CONSERVATION DIVISION  
Wichita, Kansas

D & A

We certify that the above and foregoing is a true and correct copy of the log on the #1 Hopkins located in Ness County, Kansas.

WARRIOR DRILLING, INC.



F.W. Shelton, Jr., Vice President

Subscribed and sworn to before me this 28th day of May, 1981.



*Martha E. Gustin*  
Martha E. Gustin Notary Public