


STATE OF KANSAS  
STATE CORPORATION COMMISSION

Give All Information Completely  
Make Required Affidavit  
Mail or Deliver Report to:  
Conservation Division  
State Corporation Commission  
P. O. Box 17027  
Wichita, Kansas 67217  
NORTH

WELL PLUGGING RECORD

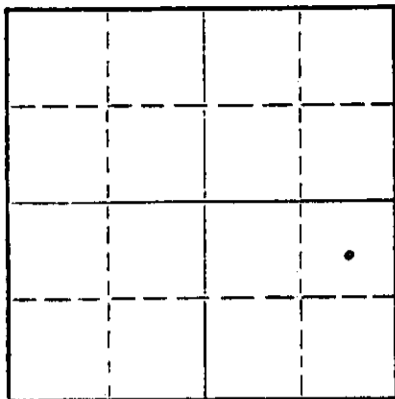

Locate well correctly on above  
Section Plot

Ness County, Sec. 34 Twp. 16 Rge. (E) 26 (W)  
Location as "NE/CNWxSWx" or footage from lines C NE SE  
Lease Owner Pickrell Drilling Company  
Lease Name Dumler L-M Unit Well No. 3  
Office Address 205 Litwin Building, Wichita, Kansas 67202  
Character of Well (completed as Oil, Gas or Dry Hole) oil  
Date well completed 19  
Application for plugging filed 19  
Application for plugging approved 19  
Plugging commenced October 1 19 76  
Plugging completed October 4 19 76  
Reason for abandonment of well or producing formation depleted

If a producing well is abandoned, date of last production 19  
Was permission obtained from the Conservation Division or its agents before plugging was commenced? YES

Name of Conservation Agent who supervised plugging of this well Leo Massey  
Producing formation \_\_\_\_\_ Depth to top \_\_\_\_\_ Bottom \_\_\_\_\_ Total Depth of Well 4540 Feet  
Show depth and thickness of all water, oil and gas formations.

OIL, GAS OR WATER RECORDS

CASING RECORD

FORMATION	CONTENT	FROM	TO	SIZE	PUT IN	PULLED OUT
			270'	8 5/8"	270'	none
			4520'	5 1/2"	4520'	1519.83

Describe in detail the manner in which the well was plugged, indicating where the mud fluid was placed and the method or methods used in introducing it into the hole. If cement or other plugs were used, state the character of same and depth placed, from \_\_\_\_\_ feet to \_\_\_\_\_ feet for each plug set.

Sanded back to 4500' and dumped 5 sacks of cement.

Allied Cementing Company plugged well pumping in 3 sacks of bulls, 30 sacks of gel and 120 sacks of cement.

RECEIVED  
STATE CORPORATION COMMISSION  
OCT 06 1976  
10-6-76  
CONSERVATION DIVISION  
Wichita, Kansas

(If additional description is necessary, use BACK of this sheet)  
Name of Plugging Contractor PIPE PULLERS, INC.  
Address Box 128, Ellinwood, Kansas 67526

STATE OF KANSAS, COUNTY OF BARTON, ss.  
Evelyn Roth (employee of owner) or (owner or operator) of the above-described well, being first duly sworn on oath, says: That I have knowledge of the facts, statements, and matters herein contained and the log of the above-described well as filed and that the same are true and correct. So help me God.

(Signature) Evelyn Roth  
Ellinwood, Kansas 67526  
(Address)

SUBSCRIBED AND SWORN TO before me this 5th day of October, 1976

JENNY KASSELMAN  
NOTARY PUBLIC  
BARTON COUNTY, KANSAS  
MY COMM. EXP. JULY 16, 1978

My commission expires \_\_\_\_\_

Jenny Kasselmann  
Notary Public.

**ROTARY DRILLING LOG**

15-135-20554-0000

**COMPANY:** Pickrell Drilling Company  
705 Fourth National Bank Building  
Wichita, Kansas 67202

Rotary Drilling Commenced 1/30/72

Rotary Drilling Completed 2/9/72

**LOCATION:** Dumler "L-M" Unit No. 3, C NE SE Section 34-16S-26W  
Ness County, Kansas

**CONTRACTOR:** PICKRELL DRILLING COMPANY  
Wichita, Kansas

**CASING RECORD:** Run 7 Jts. 8-5/8" surface casing set @ 270' KB. Cemented w/150 sacks. Completed 3 P.M. Circulated.

Ran 139 Jts. 5-1/2" Casing set @ 4520'. Cemented w/125 sacks Pozmix 4% gel followed by 35 sacks common. Plug down 8:15 A.M. January 30, 1972.

**LOG**

(Figures indicate bottom of formation — measurements from top of rotary bushing.)

140	Clay Post Rock
275	Shale
1170	Shale w/Sand Streaks
1390	Shale
1420	Blain
1500	Shale
1725	Sand
1845	Shale Red Beds
1993	Shale
2030	Anhydrite
2285	Shale
2690	Lime
2895	Lime & Shale
3310	Lime
3900	Lime & Shale
4540	Lime, RTD

C.F.S.

4440

4540

S.L.M.

Board 3940.91

Strap 3938.68

2.23 Short

Slope Tests

2000

2500

3000

3500

4000

4500

RECEIVED  
STATE CORPORATION COMMISSION

SEP 15 1976

CONSERVATION DIVISION  
Wichita, Kansas

The undersigned, C. W. Sebitts, Attorney-in-Fact for PICKRELL DRILLING COMPANY, hereby certifies in behalf of said Company, that the above is a true and correct log of the formation encountered in drilling the above well as reflected by the Daily Drilling Reports.

PICKRELL DRILLING COMPANY

By C. W. Sebitts Attorney-in-Fact

STATE OF KANSAS }  
COUNTY OF SEDGWICK } ss.:

On this 15th day of February, 1972, before me the undersigned, a Notary Public, in and for

the County and State aforesaid, personally appeared C. W. Sebitts, to me known to be the identical person who subscribed the name of PICKRELL DRILLING COMPANY to the foregoing instrument as its Attorney-in-Fact and acknowledged to me that he executed the same as his free and voluntary act and deed, and as the free and voluntary act and deed of such company, for the uses and purposes therein set forth.

Given Under my hand and seal of office the day and year last above written.

My commission expires: January 19, 1973

Esther Lamone  
Notary Public