

TYPE OR PRINT
 NOTICE: Fill out completely
 and return to Cons. Div.
 office within 30 days.

LEASE NAME Dumler LM

WELL NUMBER 1

766 Ft. from S Section Line

554 Ft. from E Section Line

SEC. 34 TWP. 16S RGE. 26W (E) or (W)

COUNTY Ness

Date Well Completed 06-28-71

Plugging Commenced 03-29-94

Plugging Completed 03-29-94

LEASE OPERATOR Pickrell Drilling Company, Inc.

ADDRESS 110 N. Market, Suite 205 Wichita, KS 67202

PHONE# (316) 262-8427 OPERATORS LICENSE NO. 5123

Character of Well Oil

(Oil, Gas, D&A, SWD, Input, Water Supply Well)

The plugging proposal was approved on 03-29-94 (date)

by Steve Middleton (KCC District Agent's Name).

Is ACO-1 filed? Yes If not, Is well log attached? No

Producing Formation Miss - Ft. Scott Depth to Top Miss, 4498 Bottom 4555 T.D. 4554

Show depth and thickness of all water, oil and gas formations.

OIL, GAS OR WATER RECORDS

CASING RECORD

Formation	Content	From	To	Size	Put in	Pulled out
Ft. Scott	Oil & Water	0	237	8 5/8	237	None
Miss	Oil & Water	0	4524	5 1/2	4524	None

Describe in detail the manner in which the well was plugged, indicating where the mud fluid was placed and the method or methods used in introducing it into the hole. If cement or other plug were used, state the character of same and depth placed, from feet to feet each set

Used 65/35 Poz mix cement 8% gel. Mixed and pumped 40 sx. cement w/ 200# cottonseed hulls. 15 sx. gel spacer. 260 sx. cement. Maximum pressure 500#. Shut in with 100#.

Name of Plugging Contractor Allied Cementing Company License No. N/A

Address P.O. Box 628, Great Bend, Kansas 67530-0628

NAME OF PARTY RESPONSIBLE FOR PLUGGING FEES: Pickrell Drilling Company, Inc.

STATE OF Kansas COUNTY OF Sedgwick, ss. 5-5-94

Jack Gurley

(Employee of Operator or (Operator) of


above-described well, being first duly sworn on oath, says: that I have knowledge of the facts statements, and matters herein contained and the log of the above-described well as filed the the same are true and correct, so help me God.

(Signature) Jack Gurley

(Address) 110 N. Market, Suite 205 Wichita, KS 67202

AND SWORN TO before me this 4th day of May, 19 94

Karen A. Mans Notary Public

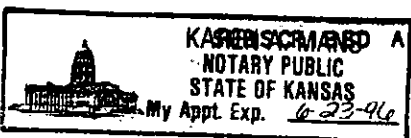

My Commission Expires: 6-23-96


USE ONLY ONE SIDE OF EACH FORM

BAKER SERVICE TOOLS - TALLY PAD

New Completion Workover

15735-20449-0000

Oil Company _____ Well No. 1 Field _____ Lease Dumler LM
Company Man _____ Date Drilled 1971 County Ness State KS

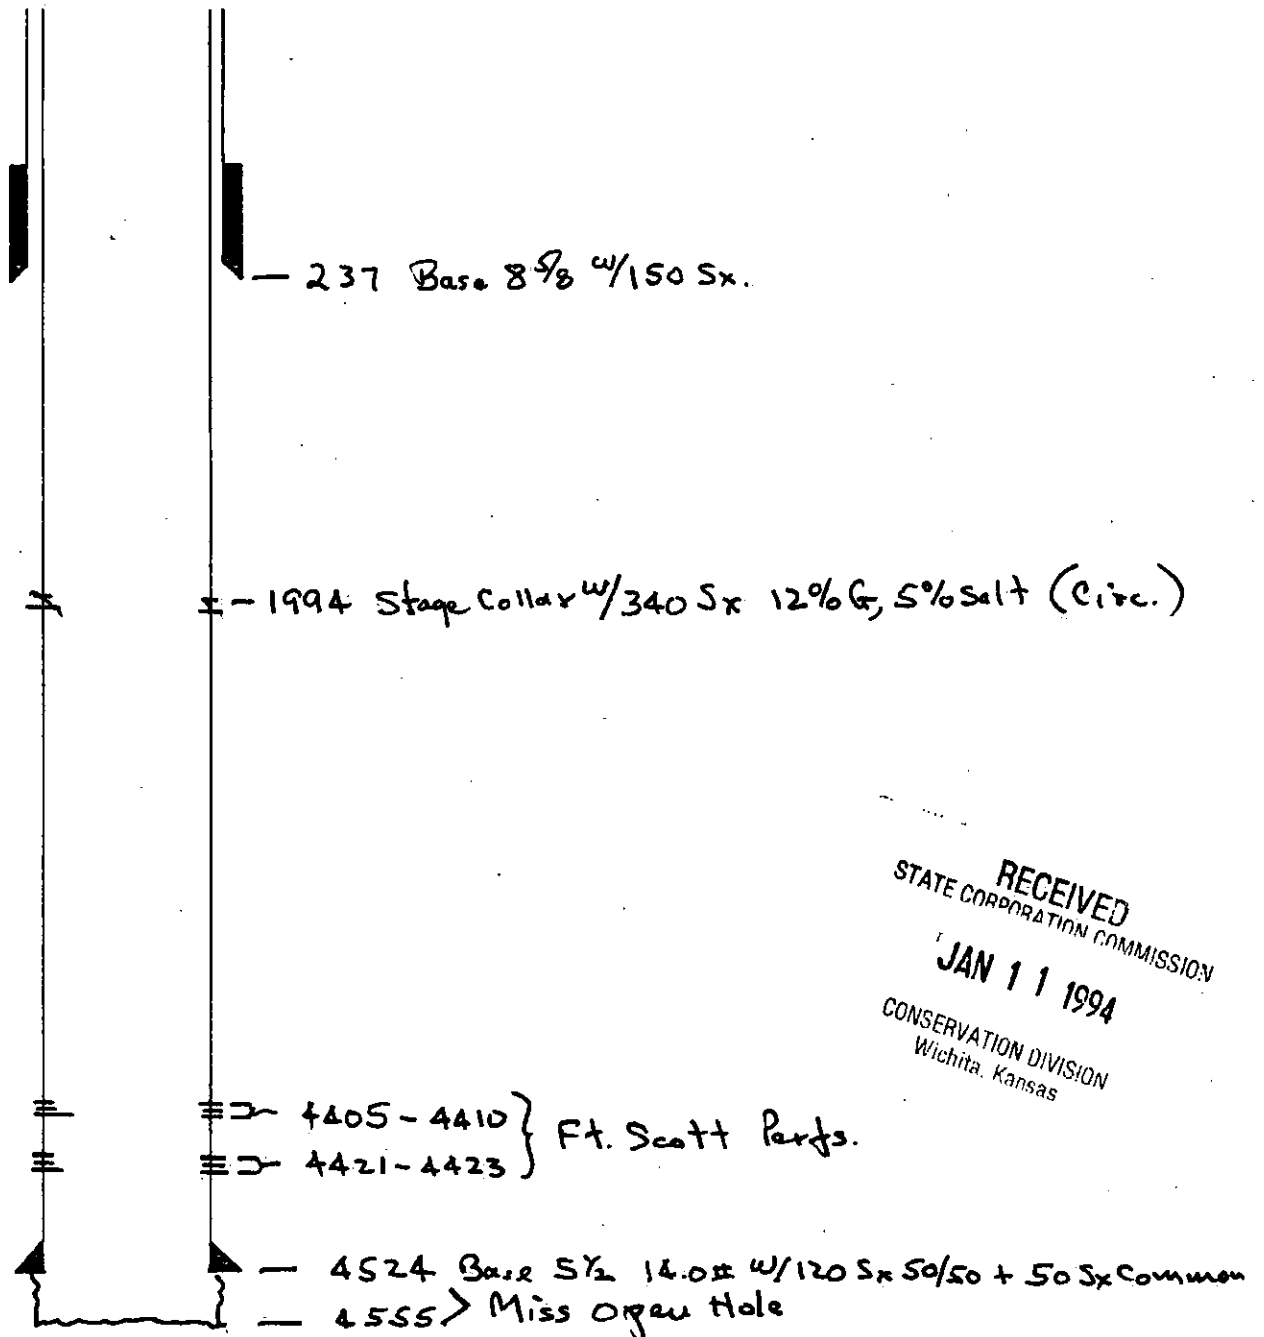

RECEIVED
STATE CORPORATION COMMISSION
JAN 11 1994
CONSERVATION DIVISION
Wichita, Kansas

REMARKS: _____

WELL F: 20

15-135-20449-0000



RADIATION-GUARD LOG

COMPANY PICKRELL DRILLING COMPANY WELL DUMLER "N" # 1 FIELD WILDCAT County NESS State KANS.	COMPANY <u>PICKRELL DRILLING COMPANY</u>		WICHITA FILE COPY.	
	WELL <u>DUMLER</u> ^{LM Unit #1} _{"N" # 1}			
	FIELD <u>WILDCAT</u>		COUNTY <u>NESS</u> STATE <u>KANSAS</u>	
	Location <u>C-SE-SE</u>		Other Services: Ø K	
Sec. <u>34</u> Twp <u>16S</u> Rge <u>26W</u>		Permanent Datum <u>GROUND LEVEL</u> Elev. <u>2590'</u>		
Log Measured From <u>KELLY BUSHING</u> Ft. Above Perm. Datum		Elev.: K.B. <u>2595'</u>		
Drilling Measured From <u>KELLY BUSHING</u>		D.F. <u>2592'</u>		
		G.L. <u>2590'</u>		
Date	6-16-71	6-16-71	6-16-71	
Run No.	ONE	GAMMA	NEUTRON	GUARD
Depth-Driller	4530'	4530'	4530'	4530'
Depth-Welex	4529'	4529'	4529'	4529'
Btm. Log Inter.	4529'	4529'	4529'	4521'
Top Log Inter.	0'	0'	3500'	3500'
Casing-Driller	@	@	8-3/8" @ 260'	8-3/8" @ 260'
Casing-Welex			260'	260'
Bit Size			7-7/8"	7-7/8"
Type Fluid in Hole			SALT BASE	SALT BASE
			GEL	GEL
Dens. Visc.			9.7 55	
pH Fluid Loss	ml	ml	6.6 8.0 ml	ml
Source of Sample			FLO LINE	FLO LINE
R ₁₀₀ @ Meas.Temp.	@ °F	@ °F	.16 @ 90°F	@ °F
R ₁₀₀ @ Meas.Temp.	@ °F	@ °F	.12 @ 90°F	@ °F
R ₁₀₀ @ Meas.Temp.	@ °F	@ °F	.224 @ 90°F	@ °F
Source R ₁₀₀ R ₁₀₀₀			MEAS.	
R ₁₀₀ @ BHT	@ °F	@ °F	.114 @ 125°F	@ °F
Time Since Circ.			TWO HOURS	TWO HOURS
Max. Rec. Temp.	°F @	°F @	125° @ BH	°F @
Equip. Location	7434 HAYS			
Recorded By	J. DAVIS			
Witnessed By	MR. RUWWE			

RECEIVED
JAN 1 1994