


15-135-19073-0000
WELL PLUGGING RECORD

Give All Information Completely
Make Required Affidavit
Mail or Deliver Report to:
Conservation Division
State Corporation Commission
211 No. Broadway
Wichita, Kansas

NORTH

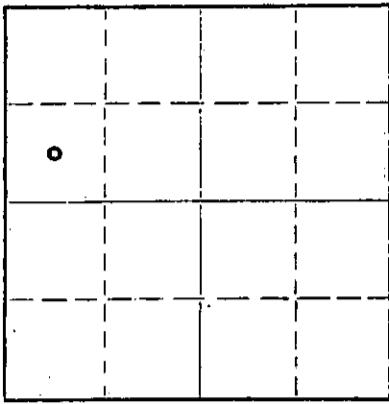

Locate well correctly on above
Section Plat

Ness County. Sec. 33 Twp 16S Rge. 26W (E) (W)
Location as "NE/CNW&SW" or footage from lines c SW NW
Lease Owner Jennings & Clogg
Lease Name Horchem Well No. 1
Office Address 662 1st Natl. Bldg., Oklahoma City, Okla.
Character of Well (completed as Oil, Gas or Dry Hole) Dry Hole
Date well completed January 6, 19 63
Application for plugging filed January 6, 19 63
Application for plugging approved January 6, 19 63
Plugging commenced January 6, 19 63
Plugging completed January 6, 19 63
Reason for abandonment of well or producing formation Dry Hole

If a producing well is abandoned, date of last production _____ 19____
Was permission obtained from the Conservation Division or its agents before plugging was commenced? yes

Name of Conservation Agent who supervised plugging of this well Eldon Petty, Box 326, Hays, Kansas
Producing formation _____ Depth to top _____ Bottom _____ Total Depth of Well _____ Feet
Show depth and thickness of all water, oil and gas formations.

OIL, GAS OR WATER RECORDS

CASING RECORD

FORMATION	CONTENT	FROM	TO	SIZE	PUT IN	PULLED OUT
		0	278'	8 5/8"	278'	none

Describe in detail the manner in which the well was plugged, indicating where the mud fluid was placed and the method or methods used in introducing it into the hole. If cement or other plugs were used, state the character of same and depth placed, from _____ feet to _____ feet for each plug set.

Set plug @ 660' 20 sacks cement and 1/2 sacks hulls
plug @ 240' 20 sacks cement and 1/2 sacks hulls
plug @ 40' 10 sacks cement and 1/2 sacks hulls

RECEIVED
STATE CORPORATION COMMISSION
JAN 15 1963
1-15-63
CONSERVATION DIVISION
Wichita, Kansas

(If additional description is necessary, use BACK of this sheet)
Name of Plugging Contractor Hellar Drilling Company, Inc.
Address 1014 Union Center, Wichita 2, Kansas

STATE OF Kansas COUNTY OF Sedgwick, ss.
D. L. Hellar, Pres. of Hellar Drlg. Co. Inc. (employee of owner) or (owner or operator) of the above-described well, being first duly sworn on oath, says: That I have knowledge of the facts, statements, and matters herein contained and the log of the above-described well as filed and that the same are true and correct. So help me God.
(Signature) D. L. Hellar D. L. Hellar, Pres.
1014 Union Center, Wichita 2, Kansas
(Address)

SUBSCRIBED AND SWORN to before me this 14th day of January, 19 63
Catherine Darcey
Catherine Darcey -- Notary Public.
My commission expires March 25, 1964.

INVOICED
DATE 1/15/63
INV. NO. 6434-u

15785-19073-0000

DRILLER'S LOG

COMPANY:
CONTRACTOR:
LEASE:
LOCATION:
COMMENCED:
COMPLETED:
CASING:

Jennings & Clogg
Hellar Drilling Company, Inc.
#1 Horchem
c SW NW Sec. 33-16S-26W, Ness County, Kansas
December 14, 1962
January 6, 1963
Set 8 5/8" surface casing @ 278'/185 sacks
cement

0- 278	Shale
279- 800	Red Beds & Shale
800- 873	Shale
873-1152	Shale & Sand
1152-1196	Blaine-Anhydrite
1196-1383	Shale-Red Bed & Sand
1383-1825	Shale-Sand
1825-2055	Shale-Red Beds
2055-2089	Cimm.
2089-2125	Shale-Red Beds
2125-2395	Shale & Salt Section
2395-2650	Salt Section
2650-2833	Shale & Lime
2833-2970	Lime & Shale
2970-3012	Lime
3012-3960	Lime & Shale
3960-4095	Lansing-K.C.
4095-4326	Lime
4326-4510	Lime & Shale
4510-4577	Lime
4577-4675	Mississippi
4675	Rotary Total Depth
	Dry & Abandoned

STATE OF KANSAS
JAN 15 1963
CONSERVATION DIVISION
Wichita, Kansas

STATE OF KANSAS)
) SS
COUNTY OF SEDGWICK)

I, D. L. Hellar, do hereby certify that the above and foregoing is a true and correct copy of the log of the #1 Horchem, located in the c SW/4 NW/4 Section 33-16S-26W, Ness County, Kansas, as reflected by the files of the Hellar Drilling Company, Inc.

HELLAR DRILLING COMPANY, INC.

By D. L. Hellar
D. L. Hellar - President

Subscribed and sworn to before me, a Notary Public, in and for Sedgwick County, Kansas, this 14th day of January, 1963.

Catherine Daycey
Notary Public - Catherine Daycey

My Commission Expires:
March 25, 1964.