


WELL PLUGGING RECORD

Give All Information Completely
Make Required Affidavit
Mail or Deliver Report to:
Conservation Division
State Corporation Commission
800 Bitting Building
Wichita, Kansas

Butler County, Sec. 35 Twp. 33 Rge. ~~8XXX~~ 6(W)

Location as "NE/CNW/SW" or footage from lines 330'S 990'W of NE Corner
Lease Owner Cities Service Oil Company
Lease Name Hoopes Well No. 1
Office Address Bartlesville, Oklahoma
Character of Well (completed as Oil, Gas or Dry Hole) Dry Hole
Date well completed March 26, 19 54
Application for plugging filed April 1, 19 54
Application for plugging approved March 30, 19 54
Plugging commenced March 26, 19 54
Plugging completed March 26, 19 54
Reason for abandonment of well or producing formation Dry Hole

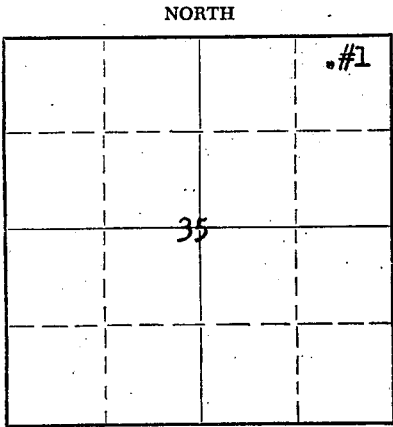

Locate well correctly on above Section Plat

If a producing well is abandoned, date of last production _____ 19____
Was permission obtained from the Conservation Division or its agents before plugging was commenced? yes

Name of Conservation Agent who supervised plugging of this well Mr. Ruel Durkee, Box 597, McPherson, Kansas
Producing formation _____ Depth to top _____ Bottom _____ Total Depth of Well 5172' Feet
Show depth and thickness of all water, oil and gas formations.

OIL, GAS OR WATER RECORDS

CASING RECORD

FORMATION	CONTENT	FROM	TO	SIZE	PUT IN	PULLED OUT
				10 3/4"	340'	Left in

Describe in detail the manner in which the well was plugged, indicating where the mud fluid was placed and the method or methods used in introducing it into the hole. If cement or other plugs were used, state the character of same and depth placed, from _____ feet to _____ feet for each plug set.

Mud to 250' and set bridge, rock to 245' and 15 sacks of cement to 215'. Mud to 18' and cemented with 5 sacks of cement. Fill to surface.

(If additional description is necessary, use BACK of this sheet)
Name of Plugging Contractor White & Ellis Drig.
Address El Dorado, Kansas

STATE OF Kansas, COUNTY OF Butler, ss.
C. D. Bradbury (employee of owner) or (owner or operator) of the above-described well, being first duly sworn on oath, says: That I have knowledge of the facts, statements, and matters herein contained and the log of the above-described well as filed and that the same are true and correct. So help me God.

(Signature) C. D. Bradbury

(Address) _____

SUBSCRIBED AND SWORN to before me this 6th day of April, 1954

My commission expires June 6, 1955

24-7368-S 3-53-20M

PLUGGING
FILE SEC 35 T 33 R 6W
BOOK PAGE 23 LINE 41

RECEIVED Notary Public.
STATE CORPORATION COMMISSION

APR 7 1954

CONSERVATION DIVISION
Wichita, Kansas

04-07-1954

Cities Service Oil Company

15-077-00142-00-00

Sec. 35-33S-6W
Harper County, Ks.

Hoopes #1

Drlg. Comm: 2-17-54
Drlg. Comp: 3-26-54
Drld. By: White & Ellis Drlg. Co.

Loc: 330'S, 990'W of NE Corner
Elev: 1257' D.F.
Note: All measurements taken from RTB.

T.D. 5172'

R.T.D. 5172'

I.P: D & A

Straight Hole Survey: (Totco)

Casing Record:
10 3/4" set at 340' w/400 sax.

500' 1/20
1000' 1/40
1530' 00
2020' 00
2500' 1/40
3500' 10
4014' 10

<u>Formation Record:</u>	<u>Depth:</u>
Red Rock - sandy	0- 60
Red Rock - Hard	100
Red shale	330
Red shale & lime	340
Red bed shale	370
Red & blue bed shale	410
Blue bed shale	515
Sandy shale	980
Lime	1220
Lime & shale	1440
Sandy shale	1490
Lime	1740
Shale & shells	2160
Shale & sand	2230
Shale & shells	2305
Lime & shale	2420
Shale & shells	2463
Shale	2495
Lime	2585
Shale & shells	2665
Sand	2705
Shale	2748
Lime	3115
Shale & shells	3165
Lime	3225
Shale (sandy	3245
Sand	3370
Shale	3460
Sand & shale	3375
Lime	4103
Shale & lime	4170
Lime	4268
Shale	4342
Lime & shale	4471
Lime	4777
Lime & shale	4853
Sand	4944
Sand & shale	5097
Lime	5172

Steel Line Measurement:

2500' = 2500'
3500' = 3500'
4014' = 4014'
4485' = 4485'

Core #1 - 4453-4461'
Core #2 - 4461-4465'
Core #3 - 4467-4477'

D.S.T. #1 - 4450-65'
D.S.T. #2 - 4465-77' (failed)
D.S.T. #3 - 4465-77'
D.S.T. #4 - 4848-57'

Top Douglas Ss.	3221'	(-1964)
Top Lansing Ls.	3456'	(-2199)
Top Stalnaker Ss.	3462'	(-2205)
Top Kansas City Ls.	3745'	(-2488)
Top Oswego	4064'	(-2807)
Top Cherokee	4253'	(-2996)
Top Miss. Ls.	4453'	(-3196)
Top Kinderhook	4752'	(-3495)
Top Viola Ls.	4846'	(-3589)
Top Simpson Ss.	4849'	(-3592)
Top Arbuckle	5063'	(-3806)

No oil noted in any of the above formations.

T.D. 5172'

PLUGGING
FLX SEC 35 T 33 R 6W
BOOK PAGE 23 LINE 11

4-1-54 bh

RECEIVED
STATE OF KANSAS
03-03-1954
APR 3 1954

CONSERVATION DIVISION
Wichita, Kansas