

15-077-20660-00-00


STATE OF KANSAS
STATE CORPORATION COMMISSION

WELL PLUGGING RECORD

Give All Information Completely
Make Required Affidavit
Mail or Deliver Report to
Conservation Division
State Corporation Comm.
245 North Water
Wichita, KS 67202

Harper County, Sec. 33 Twp. 33S Rge. 6W E/W
Location as "NE/CNW $\frac{1}{4}$ SW $\frac{1}{4}$ " or footage from lines
C N/2 NW

Lease Owner Stelbar Oil Corporation
Lease Name Maddux Well No. 2
Office Address 450 Fourth Financial Center Wichita, Ks. 67202
Character of Well (Completed as Oil, Gas or Dry Hole)
Dry Hole

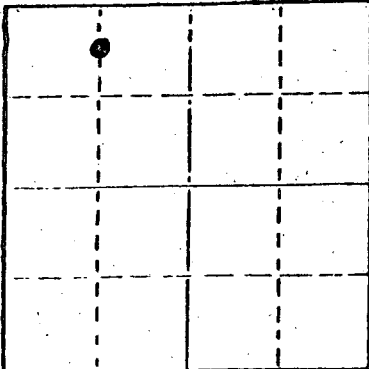

Locate well correctly on above
Section Plot

Date Well completed 2-10 1981
Application for plugging filed 2-10 1981
Application for plugging approved 2-10 1981
Plugging commenced 2-10 1981
Plugging completed 2-10 1981

Reason for abandonment of well or producing formation
Dry Hole

If a producing well is abandoned, date of last production
19

Was permission obtained from the Conservation Division or
its agents before plugging was commenced? Yes

Name of Conservation Agent who supervised plugging of this well Morris Leslie
Producing formation _____ Depth to top _____ Bottom _____ Total Depth of Well _____
Show depth and thickness of all water, oil and gas formations.

OIL, GAS OR WATER RECORDS

CASING RECORD

FORMATION	CONTENT	FROM	TO	SIZE	PUT IN	PULLED OUT
Surface pipe		-0-	255	8 5/8"	255	None

Describe in detail the manner in which the well was plugged, indicating where the mud fluid was placed and the method or methods used in introducing it into the hold. If cement or other plugs were used, state the character of same and depth placed, from _____ feet to _____ feet for each plug set.

Filled hole with heavy mud.

1 plug set @ 250' with 40 sacks cement.

2 plug set @ 40' with 10 sacks cement.

3 plug set in rat hole with 10 sacks cement.

RECEIVED
STATE CORPORATION COMMISSION

FEB 19 1981

02-19-1981

CONSERVATION DIVISION
Wichita, Kansas

(If additional description is necessary, use BACK of this sheet)

Name of Plugging Contractor Sweetman Drilling, Inc.

STATE OF Kansas COUNTY OF Barton, ss.
Gary L. Hawk (employee of owner) or ~~Owner or Operator~~


of the above-described well, being first duly sworn on oath, says: That I have knowledge of the facts, statements, and matters herein contained and the log of the above-described well as filed and that the same are true and correct. So help me God.

(Signature) Gary L. Hawk
P.O. Box 645 Great Bend, Kansas 67530
(Address)

SUBSCRIBED AND SWORN TO before me this 17th day of February, 1981

Mary Ann Schwamborn
Notary Public.

My commission expires 8-1-81

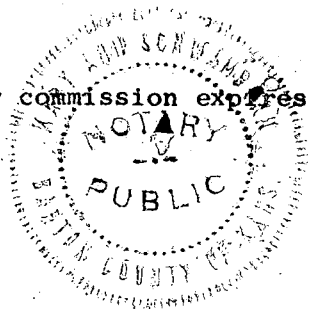

15-077-20660-00-00

WELL LOG
Maddux # 2
C N/2 NW 33-33S-6W
Harper County, Kansas

Name of Operator: Stelbar Oil Corporation
450 Fourth Financial Center
Wichita, Kansas 67202

Date Completed: February 9, 1981

FROM	TO	
0	820	Red Bed and Shale
820	1328	Shale
1328	4520	Lime and Shale
4520		Total Depth

RECEIVED
STATE CORPORATION COMMISSION

FEB 19 1981
02-19-1981
CONSERVATION DIVISION
Wichita, Kansas

STATE OF KANSAS
COUNTY OF BARTON ss

Gary L. Hawk, Secretary of Sweetman Drilling, Inc., being first duly sworn on oath says: That I have knowledge of the facts, statements and matters herein contained and the log of the above described well as filed and that the same are true and correct.

Gary L. Hawk
Gary L. Hawk

Subscribed and sworn before me this 17th day of February, 1981.

Mary Ann Schwab
Notary Public Barton County

My commission expires 8-1-81.

