

15-077-00061-00-00


WELL PLUGGING RECORD

Give All Information Completely
Make Required Affidavit
Mail or Deliver Report to:
Conservation Division
State Corporation Commission
800 Bitting Building
Wichita, Kansas

Harper County, Sec. 13 Twp. 33S Rge. 6W (E) (W)

Location as "NE/CNW/SW" or footage from lines NE NW NW
Lease Owner The Texas Company
Lease Name J. B. Harrison (NCT-1) Well No. 1
Office Address 614 Bitting Building, Wichita, Kansas
Character of Well (completed as Oil, Gas or Dry Hole) Dry
Date well completed Feb. 27 1955
Application for plugging filed (Verbal 2-27) Feb. 28 1955
Application for plugging approved (Verbal 2-27) March 1 1955
Plugging commenced Feb. 27 1955
Plugging completed Feb. 27 1955
Reason for abandonment of well or producing formation _____

NORTH

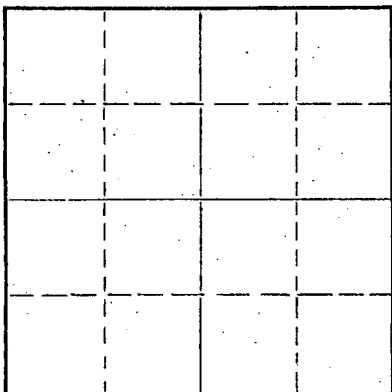

Locate well correctly on above Section Plat

If a producing well is abandoned, date of last production _____ 19____
Was permission obtained from the Conservation Division or its agents before plugging was commenced? Yes

Name of Conservation Agent who supervised plugging of this well Mr. Ruel Durkee
Producing formation _____ Depth to top _____ Bottom _____ Total Depth of Well 5033 Feet
Show depth and thickness of all water, oil and gas formations.

OIL, GAS OR WATER RECORDS

CASING RECORD

FORMATION	CONTENT	FROM	TO	SIZE	PUT IN	PULLED OUT
				10-3/4"	507'	0'

Describe in detail the manner in which the well was plugged, indicating where the mud fluid was placed and the method or methods used in introducing it into the hole. If cement or other plugs were used, state the character of same and depth placed, from _____ feet to _____ feet for each plug set.

PLUGGED AS FOLLOWS:

5033' to 250' - Heavy Mud
250' - Plug
250' to 220' - 20 Sacks Cement
220' to 30' - Heavy Mud
30' - Plug
30' to Bottom of Cellar - 10 Sacks Cement

(If additional description is necessary, use BACK of this sheet)
Name of Plugging Contractor Stickle Drilling Company
Address Box 117, Great Bend, Kansas

STATE OF Kansas, COUNTY OF Sedgwick, ss.
M. C. Harrell (employee of owner) or (owner or operator) of the above-described well, being first duly sworn on oath, says: That I have knowledge of the facts, statements, and matters herein contained and the log of the above-described well as filed and that the same are true and correct. So help me God.

(Signature) M. C. Harrell
614 Bitting Building, Wichita, Kansas
(Address)

SUBSCRIBED AND SWORN TO before me this 2nd day of March, 1955

My commission expires September 20, 1956

H. Howard Kistler
Notary Public.

PLUGGING
FILE SEC 13 T 33 R 6 W
BOOK PAGE 10 LINE 23

RECEIVED
STATE CORPORATION COMMISSION
04-01-1955
APR - 1 1955

CONSERVATION DIVISION
Wichita, Kansas

The Texas Company
Tulsa, Oklahoma

15-077-00061-00-00

Tulsa, Oklahoma
March 7, 1955

CONTRACTOR: Stickle Drilling Company
Drilling Commenced: January 31, 1955
Drilling Completed: February 27, 1955

J. B. Harrison NCT #1 NE-
NW-NW-Section 13-33S-6W,
Harper County, Kansas.

Rec'd
04-01-1955

DRILLERS LOG

Sand, Shale & Shells	5-350
Red Bed & Shells	350-501
Sand & Shale	501-950
Anhydrite	950-965
Shale & Shells	965-1100
Lime & Shale	1100-1655
Shale & Shells	1655-1800
Shale & Lime	1800-1960
Shale & Shells	1960-2380
Lime & Shale	2380-2507
Shale & Lime	2507-2643
Shale	2643-2720
Lime & Shale	2720-2855
Shale & Lime	2855-3000
Shale & Shells	3000-3122
Shale & Lime	3122-3326
Shale & Sand	3326-3573
Lime & Shale	3573-3620
Shale	3620-3735
Shale & Lime	3735-3767
Lime	3767-3959
Lime & Shale	3959-4261
Shale & Lime	4261-4315
Lime & Shale	4315-4358
Shale & Lime	4358-4367
Hard Sand & Lime	4367-4387
Lime	4387-4722
Shale	4722-4805
Sand	4805-4831
Hard Sand	4831-4837
Sand	4837-4895
Sand & Shale	4895-4940
Shale	4940-4957
Sand	4957-4980
Sand & Lime	4980-4999
Lime	4999-5033 TD


I, Frank E. Stickle hereby certify the above to be a true and complete drillers log of The Texas Company's J. B. Harrison NCT #1 NE NW NW Section 13-33S-6W, Harper County, Kansas.

Frank E. Stickle
Frank E. Stickle

William T. Bonham
Notary Public

February 13, 1956

My Commission Expires

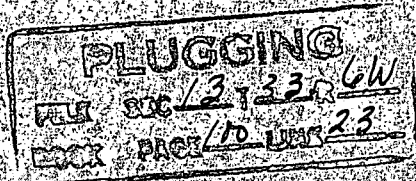

15-077-00061 00-00

LOG OF WELL

SHEET No. 2

District Kansas Owner The Texas Company Farm J. B. Harrison (NCT-Well No. 1

FORMATION	AMOUNT	COLOR	HARD OR SOFT	DEPTH CORES TAKEN	REMARKS
<u>REMARKS:</u>					
2-17-55					Ran DST #1 from 4446-56', open 1 hour, recovered 25' drilling mud, IFP 16#, FFP 25#, SIBHP 64# in 20 minutes. Ran DST #2 from 4453-72', open 1-1/2 hours, recovered 75' mud, top 25' flecked with oil. IFP 15#, FFP 45#, BHP 420# in 30 minutes.
2-21-55					Took Core #1 from 4805-15', recovered 10'.
2-22-55					Took Core #2 from 4815-25', recovered 10'.
2-23-55					Ran DST #3 from 4800-25', open 1 hour, recovered 3050' salt water. IFP 110#, FFP 1430#, BHP 1940# in 30 minutes.
2-28-55					Drilled to 5033' in time. Ran Schlumberger Survey. Well non-commercial. Plugged and abandoned.
<u>TOPS:</u>					
Penn.-Perman-----2147					
Severy-----2642					
Topeka-----2716					
Heebner-----3103					
Toronto-----3136					
Amazonian-----3212					
Stalnaker-----3504					
Kansas City-----3738					
Base Kansas City-3967					
Marmaton-----4040					
Cherokee-----4176					
Mississippi-----4362					
Kinderhook-----4712					
Simpson-Dolomite-4794					
Simpson-Sand-----4814					
Simpson-Shale----4888					
Lower Simpson Sd-4968					
Arbuckle-----4984					