


STATE OF KANSAS  
STATE CORPORATION COMMISSION

Give All Information Completely  
Make Required Affidavit  
Mail or Deliver Report to:  
Conservation Division  
State Corporation Commission  
P. O. Box 17027  
Wichita, Kansas 67217  
NORTH

WELL PLUGGING RECORD

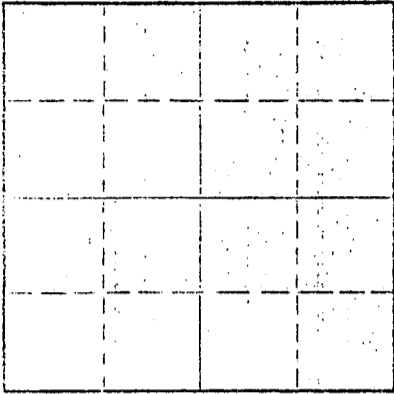

Locate well correctly on above  
Section Plat

Harper County, Sec. 13 Twp. 33S Rge. (E) 6W (W)  
Location as "NE/CNW/SE/SW" or footage from lines C NE SW  
Lease Owner D N B DRILLING, INC.  
Lease Name Hanby Well No. 1  
Office Address 701 First Nat'l Bldg., Wichita, Kansas 67202  
Character of Well (completed as Oil, Gas or Dry Hole) Dry Hole  
Date well completed 9-27 19 72  
Application for plugging filed 9-27 19 72  
Application for plugging approved 9-27 19 72  
Plugging commenced 9-27 19 72  
Plugging completed 9-27 19 72  
Reason for abandonment of well or producing formation No commercial quantities of oil or gas encountered.  
If a producing well is abandoned, date of last production 19  
Was permission obtained from the Conservation Division or its agents before plugging was commenced? Yes

Name of Conservation Agent who supervised plugging of this well G. Russell Biberstein  
Producing formation Depth to top Bottom Total Depth of Well 4877 Feet  
Show depth and thickness of all water, oil and gas formations.

OIL, GAS OR WATER RECORDS

CASING RECORD

FORMATION	CONTENT	FROM	TO	SIZE	PUT IN	PULLED OUT
Surface Hole	Water	Surface	210'	8-5/8"	205'	None

Describe in detail the manner in which the well was plugged, indicating where the mud fluid was placed and the method or methods used in introducing it into the hole. If cement or other plugs were used, state the character of same and depth placed, from feet to feet for each plug set.

Fluid to 180, plug, 25 sx cement;  
Fluid to 40, plug, 10 sx cement;  
Two sacks cement in rat hole.

RECEIVED  
STATE CORPORATION COMMISSION  
OCT 4 1972  
CONSERVATION DIVISION  
Wichita, Kansas

(If additional description is necessary, use BACK of this sheet)  
Name of Plugging Contractor D N B DRILLING, INC.  
Address 701 First National Bldg., Wichita, Kansas 67202

STATE OF KANSAS COUNTY OF ss.  
JAMES L. DONELSON (employee of owner) or (owner or operator) of the above-described well, being first duly sworn on oath, says: That I have knowledge of the facts, statements, and matters herein contained and the log of the above-described well as filed and that the same are true and correct. So help me God.

(Signature) James L. Donelson  
701 First Nat'l Bldg., Wichita, Kansas  
(Address)

SUBSCRIBED AND SWORN TO before me this 3rd day of October, 1972

My commission expires August 25, 1976

Ella Priess  
Ella Priess Notary Public.

15-077-20161-00-00

DRILLERS' LOG

D N B DRILLING, INC.  
No. 1 Hanby  
C NE SW, Sec. 13-33S-6W  
Harper County, Kansas

Elev: 1338 K.B.

Commenced: 9-17-72  
Completed: 9-27-72

Surface Casing: 205' of  
8-5/8" cemented w/140 sx  
cement. 9-17-72

FORMATION

DEPTH

Surface Hole	0 - 210
Shale	210 - 844
Shale & Lime	844 - 1545
Lime & Shale	1545 - 1821
Shale & Lime	1821 - 2046
Lime & Shale	2046 - 2850
Lime, Shale & Sand	2850 - 3110
Lime & Shale	3110 - 3390
Shale	3390 - 3540
Sand	3540 - 3610
Lime & Shale	3610 - 3774
Lime	3774 - 4252
Lime & Shale	4252 - 4429
Lime	4429 - 4726
Lime & Shale	4726 - 4860
Sand	4860 - 4877 T.D.

RECEIVED  
STATE CORPORATION COMMISSION  
OCT 4 1972  
CONSERVATION DIVISION  
Wichita, Kansas  
10-04-1972

I do hereby certify that the foregoing statements are true and correct to the best of my knowledge and belief.

D N B DRILLING, INC.

*James L. Donelson*  
JAMES L. DONELSON

STATE OF KANSAS: ss:

Subscribed and sworn to before me, the undersigned, a Notary Public in and for said state, this 3rd day of October, 1972.

My Commission Expires:  
August 25, 1976

*Ella Priess*  
Ella Priess, Notary Public

