

Permit No. 714


15-077-20155-00-00

Form CP-4

STATE OF KANSAS  
STATE CORPORATION COMMISSION

WELL PLUGGING RECORD

Give All Information Completely  
Make Required Affidavit  
Mail or Deliver Report to:  
Conservation Division  
State Corporation Commission  
P. O. Box 17027  
Wichita, Kansas 67217  
NORTH

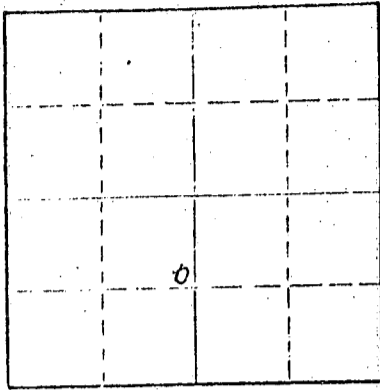

Locate well correctly on above Section Plat

Location as "NE/CNW/SE/SW" or footage from lines HARPER County, Sec 12 Twp 33S Rge 6W (E) 6 (W)  
Lease Owner J A Allison  
Lease Name WETHINGTON Well No. #1  
Office Address \_\_\_\_\_  
Character of Well (completed as  Oil  Gas or Dry Hole) \_\_\_\_\_  
Date well completed 6-30 1972  
Application for plugging filed \_\_\_\_\_ 1974  
Application for plugging approved \_\_\_\_\_ 1974  
Plugging commenced \_\_\_\_\_ 19\_\_\_\_  
Plugging completed 12-20 1974  
Reason for abandonment of well or producing formation well wouldnt pay to produce  
If a producing well is abandoned, date of last production \_\_\_\_\_ 1974  
Was permission obtained from the Conservation Division or its agents before plugging was commenced? no

Name of Conservation Agent who supervised plugging of this well Ted Dewey  
Producing formation KANSAS CITY Depth to top 3700 Bottom 3807 Total Depth of Well 4847 Feet  
Show depth and thickness of all water, oil and gas formations.

OIL, GAS OR WATER RECORDS

CASING RECORD

FORMATION	CONTENT	FROM	TO	SIZE	PUT IN	PULLED OUT

Describe in detail the manner in which the well was plugged, indicating where the mud fluid was placed and the method or methods used in introducing it into the hole. If cement or other plugs were used, state the character of same and depth placed, from \_\_\_\_\_ feet to \_\_\_\_\_ feet for each plug set.

Set Bottom plug at 3700 ft w/ SAND & Gravel w/ 5 ft of Cement shot pipe AT 2801 2710 2560 2411 2350 Recovered 2350 of 5 1/2 set top plug 260 BACK TO 230 w/ SAND AND GRAVEL 4 yards of Ready mix Cement to top

RECEIVED  
STATE CORPORATION COMMISSION

JAN 13 1975

01-13-1975

CONSERVATION DIVISION  
Wichita, Kansas

Name of Plugging Contractor F+Z Well Service  
Address Box 37 TOWANDA, KANS.

STATE OF KANSAS COUNTY OF HARPER, ss.  
I, \_\_\_\_\_ (employee of owner) or (owner or operator) of the above-described well, hereby first duly sworn on oath, says: That I have knowledge of the facts, statements, and matters herein contained and the log of the above-described well as filed and that the same are true and correct. So help me God.


(Signature) Robert H. Flowers

(Address)

day of 12-13-, 1974

Molly D. Mann  
Notary Public.

Sworn to before me this June 24, 1978

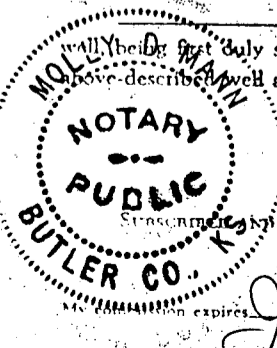

DRILLER LOG

Wethington  
No. 1 Wethington

CASING RECORD:

8 5/8" @ 247'  
w/190 sx cement  
5 1/2" @ 3650.82'  
w/175 sx cement

COMPANY: Jim Allison

CONTRACTOR: Red Tiger Drilling Co.

COMMENCED: June 15, 1972

COMPLETED: July 1, 1972

DESCRIPTION:

NE NW  
12-33S-6W  
Harper County,  
Kansas

ELEVATION:

TOTAL DEPTH: 4844'

<u>FORMATION</u>	<u>FROM</u>	<u>TO</u>	<u>REMARKS</u>
Red & Blue Shale	0	175	
Red Rock	175	247	
Red Beds	247	500	
Shale & Shells	500	710	
Shale	710	1029	
Lime & Shale	1029	1825	
Shale & Lime Shells	1825	2025	
Shale & Lime	2025	3493	
Lime	3493	3519	
Sand	3519	3582	
Shale & Lime	3582	3720	
Lansing Kansas City	3720	3787	
Lime	3787	4000	
Lime & Shale	4000	4140	
Lime	4140	4195	
Lime & Shale	4195	4240	
Lime	4240	4375	
Shale & Lime	4375	4423	
Lime	4423	4470	
Miss	4470	4540	
Lime	4540	4640	
Miss	4640	4710	
Lime & Shale	4710	4735	
Kinderhook	4735	4820	
Dolomite	4820	4824	
Simpson	4824	4844	

RECEIVED  
STATE CORPORATION COMMISSION  
OCT 10 1974  
CONSERVATION DIVISION  
Wichita, Kansas

10-10-1974

I certify that this is a true and correct copy of the above log to the best of my knowledge.

RED TIGER DRILLING COMPANY

Robert Yancer  
Robert Yancer

Subscribed and sworn to before me this 5th day of July, 1972.

Virginia K. Albert  
Notary Public



My Commission Expires:  
7-23-74