


15-077-2031600-00

FORM CP-4

STATE OF KANSAS
STATE CORPORATION COMMISSION
CONSERVATION DIVISION
P. O. BOX 17027
WICHITA, KANSAS 67217

WELL PLUGGING RECORD

Harper County, Sec. 6 Twp. 33S Rge. 6W (E) (W)

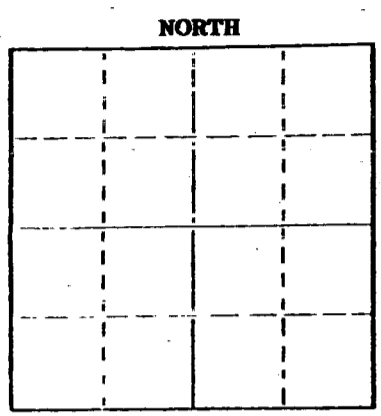

Locate well correctly on above Section Plat

Location as "NE/CNW/SE" or footage from lines _____
Lease Owner PICKRELL DRILLING COMPANY
Lease Name Holland "B" Well No. 1
Office Address 705 4th Nat'l Bank Bldg. Wichita, Ks. 67202
Character of Well (completed as Oil, Gas or Dry Hole) Dry Hole
Date well completed 7-8-75 19
Application for plugging filed 7-8-75 19
Application for plugging approved 7-8-75 19
Plugging commenced 7-8-75 19
Plugging completed 7-8-75 19
Reason for abandonment of well or producing formation Dry Hole

If a producing well is abandoned, date of last production _____ 19
Was permission obtained from the Conservation Division or its agents before plugging was commenced? Yes

Name of Conservation Agent who supervised plugging of this well G.R. Biberstein
Producing formation _____ Depth to top _____ Bottom _____ Total Depth of Well 4910 Feet
Show depth and thickness of all water, oil and gas formations.

OIL, GAS OR WATER RECORDS

CASING RECORD

FORMATION	CONTENT	FROM	TO	SIZE	PUT IN	PULLED OUT
				8 5/8	215	None

Describe in detail the manner in which the well was plugged, indicating where the mud fluid was placed and the method or methods used in introducing it into the hole. If cement or other plugs were used, state the character of same and depth placed, from _____ feet to _____ feet for each plug set.

RECEIVED 35 sacks at 200' on pipe
STATE CORPORATION COMMISSION 15 sacks at 40'
2 sacks in Rat Hole
JUL 23 1975 Job completed 10:AM 7/8/75
07-23-1975
CONSERVATION DIVISION
Wichita, Kansas

(If additional description is necessary, use BACK of this sheet)
Name of Plugging Contractor Pickrell Drilling Company
Address 705 Fourth Nat'l Bank Bldg. Wichita, Ks. 67202

STATE OF Kansas COUNTY OF Sedgwick ss.
C. W. Sebitts (employee of owner) or (owner or operator) of the above-described

well, being first duly sworn on oath, says: That I have knowledge of the facts, statements and matters herein contained and the log of the above-described well as filed and that the same are true and correct. So help me God.

(Signature) C. W. Sebitts
705 4th National Bank Bldg. Wichita, Ks. 67202
(Address)

Subscribed and sworn to before me this 15 day of July, 19 75.

My commission expires August 19, 1975
Helen L. Martin
Helen L. Martin Notary Public.

ROTARY DRILLING LOG

15-077-20316-00-00

COMPANY: PICKRELL DRILLING COMPANY
705 4th Nat'l Bank Bldg.
Wichita, Ks. 67202

Rotary Drilling Commenced 6-24-75

Rotary Drilling Completed 7-08-75

LOCATION: Holland "B" #1
C SE SE 6-33S-6W
Harper County, Kansas

CONTRACTOR: **PICKRELL DRILLING COMPANY**
Wichita, Kansas

CASING RECORD: 8 5/8 surface casing set at 215' and cemented with 150 sacks.
Job completed 6-24-75

LOG

(Figures indicate bottom of formation — measurements from top of rotary bushing.)

Hard Sand	40
Shale	219
Red Beds & Shale	350
Shale & Shell	502
Shale	1200
Shale w/lime Stks.	1340
Lime & Shale	1610
Lime & Shale	1890
Lime & Shale	2140
Lime & Shale	2400
Lime w/shale	2570
Lime & Shale	2780
Lime & Shale	3010
Lime & Shale	3210
Lime & Shale	3373
Lime & Shale	3500
Lime & Shale	3628
Lime & Shale	3730
Lime & Shale	3860
Lime & Shale	3990
Lime	4034
Lime	4065
Lime	4105
Lime & Shale	4165
Lime & Shale	4245
Lime & Shale	4320
Lime	4400
Lime & Shale	4465
Lime & Shale	4495
Miss. & Chat.	4528
Miss.	4560
Lime	4600
Lime & Chert.&Shale	4720
Lime & Shale & Chert	4800
Lime	4855
Woodford Shale	4866
Woodford Shale	4874
Dolomite	4894
Sand	4910

RECEIVED
STATE CORPORATION COMMISSION
JUL 23 1975
CONSERVATION DIVISION
Wichita, Kansas

07-23-1975

The undersigned, C.W. Sebitts, Attorney-in-Fact for PICKRELL DRILLING COMPANY, hereby certifies in behalf of said Company, that the above is a true and correct log of the formation encountered in drilling the above well as reflected by the Daily Drilling Reports.

PICKRELL DRILLING COMPANY

By *C.W. Sebitts*
C. W. Sebitts, Attorney-in-Fact

STATE OF KANSAS }
COUNTY OF SEDGWICK } ss.:

On this 15 day of July, 19 75, before me the undersigned, a Notary Public, in and for

the County and State aforesaid, personally appeared C. W. Sebitts, to me known to be the identical person who subscribed the name of PICKRELL DRILLING COMPANY to the foregoing instrument as its Attorney-in-Fact and acknowledged to me that he executed the same as his free and voluntary act and deed, and as the free and voluntary act and deed of such company, for the uses and purposes therein set forth.

Given under my hand and seal of office the day and year last above written.

My commission expires: August 19, 1975

Helen L. Martin
Helen L. Martin, Notary Public