

CARD MUST BE TYPED

State of Kansas

CARD MUST BE SIGNED

## NOTICE OF INTENTION TO DRILL

(see rules on reverse side)

Expected Spud Date. 2/12/88  
month day year

OPERATOR: License # 4767  
 Name Ritchie Exploration, Inc.  
 Address 125 N. Market, Suite 1000  
 City/State/Zip Wichita, KS 67202  
 Contact Person Leah Ann Kasten  
 Phone 316/267-4375

CONTRACTOR: License # 6033  
 Name Murfin Drilling Co.  
 City/State Wichita, KS

Well Drilled For:	Well Class:	Type Equipment:
<input checked="" type="checkbox"/> Oil	<input type="checkbox"/> Infield	<input checked="" type="checkbox"/> Mud Rotary
<input type="checkbox"/> Gas	<input type="checkbox"/> Pool Ext.	<input type="checkbox"/> Air Rotary
<input type="checkbox"/> OWWO	<input checked="" type="checkbox"/> Wildcat	<input type="checkbox"/> Cable
<input checked="" type="checkbox"/> Storage		
<input type="checkbox"/> Inj		
<input checked="" type="checkbox"/> Expl		

If OWWO: old well info as follows:

Operator .....

Well Name .....

Comp Date ..... Old Total Depth .....

I certify that well will comply with K.S.A. 55-101, et seq., plus eventually plugging hole to KCC specifications.

Date 2/8/88 Signature of Operator or Agent Leah Ann Kasten Title Geologist

For KCC Use:

Conductor Pipe Required ..... feet; Minimum Surface Pipe Required 200 feet per Alt. X 2This Authorization Expires 8-9-88 Approved By Feb 2-9-88EFFECTIVE DATE: 2-14-88

API Number 15— 135-23,219-0000 DA

C SW SW Sec. 21 Twp. 18 S, Rg. 21 X East  
660 Ft. from South Line of Section  
4620 Ft. from East Line of Section

(Note: Locate well on Section Plat on reverse side)

Nearest lease or unit boundary line 660 feet

County Ness

Lease Name Clarence Foos Well # 1

Ground surface elevation est. 2128' feet MSL

Domestic well within 330 feet: yes X no

Municipal well within one mile: yes X no

Depth to bottom of fresh water. 100

Depth to bottom of usable water 600

Surface pipe by Alternate: 1 2 X

Surface pipe planned to be set 280

Conductor pipe required n/a

Projected Total Depth 4300 feet


Formation Mississippian

Must be filed with the K.C.C. five (5) days prior to commencing well  
This card void if drilling not started within six (6) months of date received by K.C.C.

**Important procedures to follow:**

1. Notify District office before setting surface casing.
2. Set surface casing by circulating cement to the top.
3. File completion forms ACO-1 with K.C.C. within 120 days of well spud date, following instructions on ACO-1, side 1, and including copies of wireline logs.
4. Notify District office 48 hours prior to old well workover or re-entry.
5. Prior to filing Intent, prepare a proposed plugging plan in case well is D & A, then obtain approval of plan when calling district office prior to setting surface pipe.
6. Submit plugging report (CP-4) to K.C.C. after plugging is completed.
7. Obtain an approved injection docket number before disposing of salt water.
8. Notify K.C.C. within 10 days when injection commences or terminates.
9. If an alternate 2 completion, cement in the production pipe from below any usable water to surface within 120 days of spud date.

**A Regular Section of Land**  
**1 Mile = 5,280 Ft.**

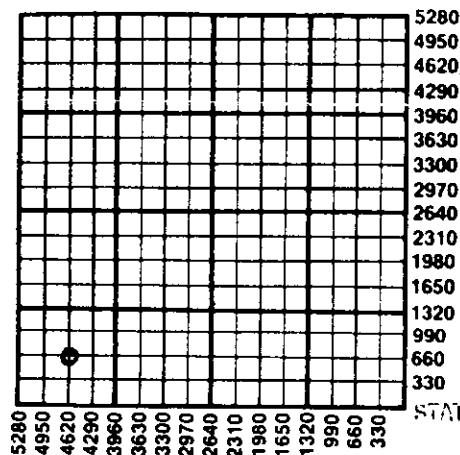

STATE CORPORATION COMMISSION

FILED 09 1988  
2-9-88  
CONSERVATION DIVISION  
Wichita, Kansas

State Corporation Commission of Kansas  
Conservation Division  
200 Colorado Derby Building  
Wichita, Kansas 67202-1212  
(316) 263-3238