


STATE OF KANSAS
STATE CORPORATION COMMISSION

Give All Information Completely
Make Required Affidavit
Mail or Deliver Report to:
Conservation Division
State Corporation Commission
212 North Market, Insurance Bldg.
Wichita, Kansas

WELL PLUGGING RECORD

NORTH

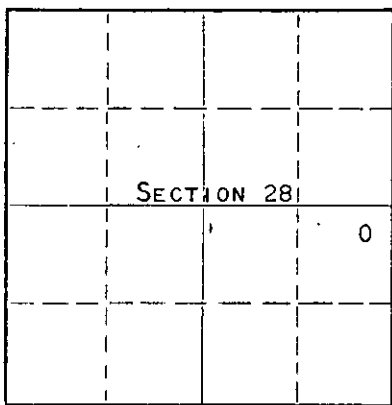

Locate well correctly on above
Section Plat

BARBER County, Sec. 28 Twp. 32s Rge. 14w ~~14w~~ (W)
Location as "NE/CNW/SW" or footage from lines APPROX. SW NE NE SE
Lease Owner PETROLEUM, INC.
Lease Name JACOBS "F" Well No. 1
Office Address ROUTE 2, GREAT BEND, KANSAS
Character of Well (completed as Oil, Gas or Dry Hole) OIL
Date well completed JUNE 8 19 58
Application for plugging filed JULY 7 19 60
Application for plugging approved JULY 12 19 60
Plugging commenced JULY 12 19 60
Plugging completed JULY 18 19 60
Reason for abandonment of well or producing formation
DEPLETION OF PRODUCIBLE ZONES
If a producing well is abandoned, date of last production JUNE 10 19 60
Was permission obtained from the Conservation Division or its agents before plugging was commenced? YES

Name of Conservation Agent who supervised plugging of this well FRED HAMPEL
Producing formation MARMATON Depth to top 4625' Bottom 4732' Total Depth of Well 4808 Feet
Show depth and thickness of all water, oil and gas formations.

OIL, GAS OR WATER RECORDS

CASING RECORD

FORMATION	CONTENT	FROM	TO	SIZE	PUT IN	PULLED OUT
MARMATON	WATER WITH	4668'	4688'	8-5/8"	1040'	NONE
	LITTLE OIL			5-1/2"	4803'	3900'

Describe in detail the manner in which the well was plugged, indicating where the mud fluid was placed and the method or methods used in introducing it into the hole. If cement or other plugs were used, state the character of same and depth placed, from _____ feet to _____ feet for each plug set.

(PLUGGED BACK TO 4692')

FILLED HOLE WITH CRUSHED ROCK FROM 4692' TO 4650', FOLLOWED BY 4 SACKS CEMENT, FILLED HOLE WITH HEAVY MUD TO 300' AND BUILT SOLID ROCK BRIDGE, PLACED 20 SACKS CEMENT ON TOP OF SOLID ROCK BRIDGE. FILLED HOLE WITH HEAVY MUD TO 35' AND BUILT SOLID ROCK BRIDGE. FILLED HOLE TO BASE OF WELL CELLAR WITH 10 SACKS CEMENT

RECEIVED
STATE CORPORATION COMMISSION

JUL 22 1960
7-22-60
CONSERVATION DIVISION
Wichita, Kansas

(If additional description is necessary, use BACK of this sheet)

Name of Plugging Contractor MORGAN WELL PLUGGING SERVICE
Address 102 WEST 18TH STREET, HUTCHINSON, KANSAS

STATE OF KANSAS, COUNTY OF BARTON, ss.
BILL BUCHHOLZ

(employee of owner) or (owner) of the above-described well, being first duly sworn on oath, says: That I have knowledge of the facts, statements, and matters herein contained and the log of the above-described well as filed and that the same are true and correct. So help me God.

(Signature)

ROUTE 2, GREAT BEND, KANSAS
(Address)

SUBSCRIBED AND SWORN TO before me this 20TH day of JULY, 19 60

Arthur J. Miles

My commission expires APRIL 14, 1963

Notary Public.

15-007-00587-0000
WELL LOG

COMPANY PETROLEUM, INCORPORATED

SEC. 28 T. 32S R. 14W

FARM JACOBS "F" NO. 1


LOC. App. C-W/2 NE, NE, SE

TOTAL DEPTH 4808'

COUNTY BARBER CO., KASAS

COMM. April 18, 1958 COMP. May 5, 1958

CONTRACTOR GARVEY DRILLING COMPANY

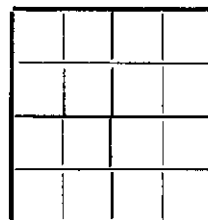

CASING 13 3/8" @ 320' W/300 sax.
8 5/8" @ 1040' W/125 sax.
5 1/2" @ 4803' W/125 sax.

ELEVATION 1929' DF

PRODUCTION Marmaton

FIGURES INDICATE BOTTOM OF FORMATIONS

100	Surface clay & sand
330	Red bed & byp w/sand streaks
435	Shells & red bed
790	Red bed & shells
1045	Dry Drill - No Returns
1190	Red bed & gyl
1400	Shale & red rock
1570	Shale
2190	Shale & lime
2515	Lime & shale
2595	Shale & lime w/sand
2715	Shale & lime
2815	Shale & shells
3005	Shale & lime
3210	Shale
3650	Shale & lime
3855	Shale & broken lime
4050	Shale & lime
4170	Shale
4255	Lime & shale
4650	Lime
4677	Lime & chert
4715	Shale, lime & sand
4722	Lime
4745	Lime & chert
4760	Chert
4775	Chert & lime
4808	Lime
4808	T. D.

RECEIVED
STATE CORPORATION COMMISSION

JUL 22 1960
7-22-60
CONSERVATION DIVISION
Wichita, Kansas

State of KANSAS }
County of BARTON } ss:

I, VERNE A. MORRIS of GARVEY DRILLING COMPANY

upon oath state that the above and foregoing is a true and correct copy of the log of the #1 JACOBS "F" well

Verne A. Morris

Subscribed and sworn to before me this 22nd day of July 19 58

My Commission Expires: July 11, 1960

Ed T. Brown
NOTARY PUBLIC