

KANSAS

FORM CP-3
Rev. 11-3-80

STATE CORPORATION COMMISSION

CONSERVATION DIVISION AGENT REPORT

API Number 15-007-21,007-0000

245 North Water
Wichita, KS 67202

Operator's Full Name Texas Oil & Gas Corp.

Complete Address 200 W. Douglas Suite 300 Wichita Ks.

Lease Name Fritz Well No. 1

Location SE NE NE Sec. 29 Twp. 32 Rge. 14 (~~###~~) (West)

County Barber Total Depth 4300' (OK) (4272')

Abandoned Oil Well X Gas Well Input Well SWD Well D & A

Other well as hereafter indicated

Plugging Contractor Clarke Corp.

Address 107 W. Fowler Medicine Lodge Ks. License No. 583

Operation Completed: Hour: 11:00 A Day: 16 Month: Dec. Year: 19 80

The above well was plugged as follows:

pumped 10 sacks cement to 4000'

set bridge 360'

6 yd. readymix

2500' of 2 7/8" recovered

423' of 8 5/8" surface

RECEIVED
STATE CORPORATION COMMISSION

JAN 6 1981
1-6-81
CONSERVATION DIVISION
Wichita, Kansas

I hereby certify that the above well was plugged as herein stated.

Signed: Carl R. Barnett
Conservation Division Agent

INVOICED


DATE 1-12-81

INV. NO. 3848-u

WELL : FRITZ 1 K-007-21007-0000

LOCATION : 330' FEL + 1000' FHL SEC. 29-32S-14 W

ELEVATION : 1985' G.L. 1994' K.B.

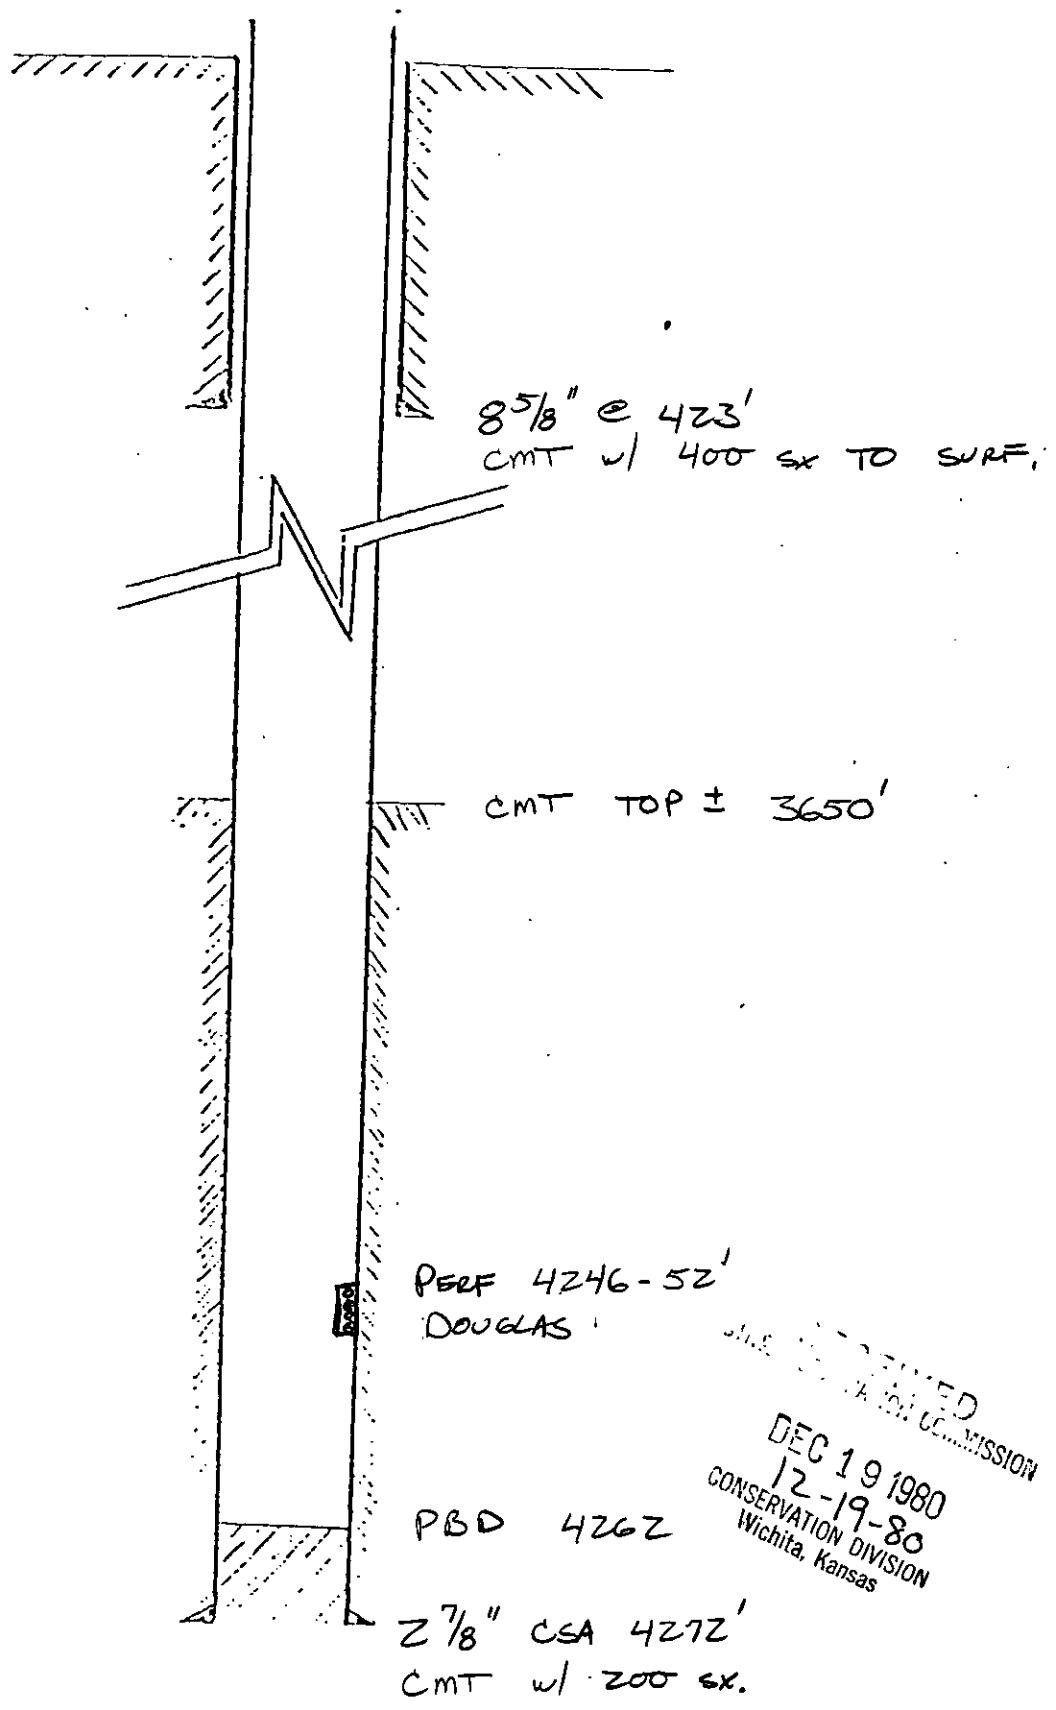

RECEIVED
KANSAS CONSERVATION COMMISSION
DEC 19 1980
12-19-80
CONSERVATION DIVISION
Wichita, Kansas

Clarke Corporation

PIPE TALLY

DATE December 15 1980

No. Pcs.	LENGTH		LENGTH		LENGTH		LENGTH		LENGTH	
	Ft.	Ins.	Ft.	Ins.	Ft.	Ins.	Ft.	Ins.	Ft.	Ins.
1	27	81	31	12	30	21	30	19	31	16
2	31	26	31	78	31	12	31	66	31	31
3	30	33	30	80	30	17	30	17	3	88
4	31	24	31	80	30	11	30	31		
5	29	29	29	16	31	34	30	56		
6	31	26	32	15	31	41	30	48		
7	31	44	31	37	29	60	29	35		
8	30	26	28	42	31	67	31	49		
9	30	48	31	50	31	15	31	21		
10	28	51	30	47	29	35	31	33		
11	29	07	30	25	29	63	31	35		
12	30	31	31	11	31	50	30	51		
13	30	84	30	69	31	15	28	77		
14	28	59	30	35	29	46	29	91		
15	29	60	31	13	29	46	31	14		
16	31	50	31	09	30	02	28	65		
17	29	82	30	33	30	88	31	44		
18	31	15	30	58	30	01	31	25		
19	30	52	30	12	31	21	31	60		
20	31	17	31	51	30	40	31	39		
Total	604	45	615	73	609	85	612	76	66	35

Col. No.		
1	604	45
2	615	73
3	609	85
4	612	76
5	66	35
Total	2,509	14

Stock of _____
 Weight 6 1/2 Size 2 1/2
 Grade _____ Coupling _____ Thd 8th
 From Texas Oil & Gas
Fritz 1
 Sent To _____
 Remarks _____
 Car No. _____
 Talled By Clarke Corp

DEC 24 1980
 CONSERVATION DIVISION
 Wichita, Kansas

No. Joints 83