


Give All Information Completely
Make Required Affidavit
Mail or Deliver Report to:
Conservation Division
State Corporation Commission
P. O. Box 17027
Wichita, Kansas 67217
NORTH

WELL PLUGGING RECORD

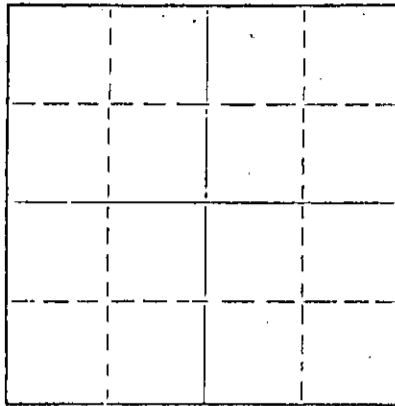

Locate well correctly on above
Section Plat

Ness County, Sec. 13 Twp. 18S Rgo. (E) 21W (W)
Location as "NE/CNWKSW" or footage from lines W/2 E/2 NE
Lease Owner Pate-Dombaugh Petroleum
Lease Name Young Well No. #1
Office Address 502 Union Center, Wichita, Kansas 67202
Character of Well (completed as Oil, Gas or Dry Hole) Dry hole
Date well completed 11-21-79 19
Application for plugging filed 11-21-79 19
Application for plugging approved 11-21-79 19
Plugging commenced 11-21-79 19
Plugging completed 11-21-79 19
Reason for abandonment of well or producing formation dry hole

If a producing well is abandoned, date of last production 19
Was permission obtained from the Conservation Division or its agents before plugging was commenced? Yes

Name of Conservation Agent who supervised plugging of this well Marion Schmidt
Producing formation _____ Depth to top _____ Bottom _____ Total Depth of Well 4130 Feet
Show depth and thickness of all water, oil and gas formations.

OIL, GAS OR WATER RECORDS

CASING RECORD

FORMATION	CONTENT	FROM	TO	SIZE	PUT IN	PULLED OUT
				8 5/8	341'	-0-

Describe in detail the manner in which the well was plugged, indicating where the mud fluid was placed and the method or methods used in introducing it into the hole. If cement or other plugs were used, state the character of same and depth placed, from _____ feet to _____ feet for each plug set.

Plugged through drill pipe @ 600' w/70 sx. 50/50 posmix, 6% gel
Plugged through drill pipe @ 340' w/20 sx. " "
Plugged through drill pipe @ 40' w/10 sx. " "
5 sx. in rathole

STATE RECEIVED
CORPORATION COMMISSION
DEC - 7 1979
CONSERVATION DIVISION
Wichita, Kansas

Name of Plugging Contractor Warrior Drilling, Inc.
Address 905 Century Plaza, Wichita, Kansas 67202

STATE OF KANSAS, COUNTY OF SEDGWICK ss.
Bill G. Lahar

(employee of owner) or (owner or operator) of the above-described well, being first duly sworn on oath, says: That I have knowledge of the facts, statements, and matters herein contained and the log of the above-described well as filed and that the same are true and correct. So help me God.

(Signature) Bill G. Lahar
905 Century Plaza, Wichita, Kansas 67202
(Address)

SUBSCRIBED AND SWORN TO before me this 27th day of November, 1979

MARILYN SINARD
STATE NOTARY PUBLIC
SEDGWICK COUNTY, KANSAS
MY APPT. EXP. 4-30-83

Marilyn Sinard
Notary Public.

DRILLERS LOG

15135-21706-0000

November 27, 1979

#1 YOUNG
W/2 E/2 NE Sec. 13-18S-21W
Ness County, Kansas

OPERATOR: Pate-Dombaugh Petroleum
CONTRACTOR: Warrior Drilling, Inc.
COMMENCED: November 12, 1979
COMPLETED: November 21, 1979

8 5/8" @ 341' w/200 sx

0	347	Surface Sand & Clay
347	1312	Sand & Shale
1312	1340	Anhydrite
1340	2530	Shale
2530	3135	Shale & Lime
3135	3706	Lime & Shale
3706	4130	Lime
4130		RTD

D & A

We certify that the above and foregoing is a true and correct copy of the log on the #1 Young located in Ness County, Kansas.

WARRIOR DRILLING, INC.

Bill G. Lahar

Bill G. Lahar, Manager of Exploration

Subscribed and sworn to before me this 27th day of November, 1979.

MARILYN SINARD STATE NOTARY PUBLIC SEDGWICK COUNTY, KANSAS MY APPT. EXP. 4-30-83

Marilyn Sinard

Marilyn Sinard

Notary Public

RECEIVED
STATE CORPORATION COMMISSION

DEC - 7 1979

CONSERVATION DIVISION
Wichita, Kansas