

STATE OF KANSAS
STATE CORPORATION COMMISSION
CONSERVATION DIVISION
P. O. BOX 17027
WICHITA, KANSAS 67217

FORM CP-4

WELL PLUGGING RECORD

Ness County, Sec. 13 Twp. 18S Rge. (E) 21W

Location as "NE/CNW/SW" or footage from lines NE NW NE

Lease Owner G. W. Breuer

Lease Name Young Well No. 1

Office Address P. O. Box 8255, Denver, Colo. 80201

Character of Well (completed as Oil, Gas or Dry Hole) Dry Hole

Date well completed 12-1 19 75

Application for plugging filed 12-1 19 75

Application for plugging approved 12-1 19 75


Plugging commenced 12-1 19 75

Plugging completed 12-1 19 75

Reason for abandonment of well or producing formation No commercial quantities of oil or gas encountered.

If a producing well is abandoned, date of last production 19

Was permission obtained from the Conservation Division or its agents before plugging was commenced? Yes

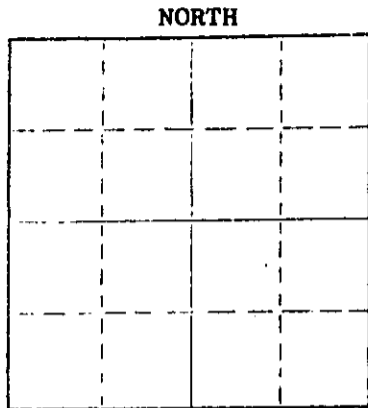

Locate well correctly on above Section Plat

Name of Conservation Agent who supervised plugging of this well Leo Massey

Producing formation Depth to top Bottom Total Depth of Well 4160 Feet

Show depth and thickness of all water, oil and gas formations.

OIL, GAS OR WATER RECORDS

CASING RECORD

FORMATION	CONTENT	FROM	TO	SIZE	PUT IN	PULLED OUT
Surface Hole	Water	Surf.	318	8-5/8"	310	None

Describe in detail the manner in which the well was plugged, indicating where the mud fluid was placed and the method or methods used in introducing it into the hole. If cement or other plugs were used, state the character of same and depth placed, from feet to feet for each plug set.

Filled hole with mud, squeezed with 125 sx common cement thru 8-5/8" surface casing.

RECEIVED
STATE CORPORATION COMMISSION

DEC 15 1975

12-15-75

Name of Plugging Contractor (If additional description is necessary, use BACK of this sheet) D N B DRILLING, INC.

Address 701 First National Building

Wichita, Kansas 67202

CONSERVATION DIVISION
Wichita, Kansas

STATE OF JAMES L. DONELSON COUNTY OF ss.

(employee of owner) or (owner or operator) of the above-described well, being first duly sworn on oath, says: That I have knowledge of the facts, statements, and matters herein contained and the log of the above-described well as filed and that the same are true and correct. So help me God.

(Signature) James L. Donelson

701 First Nat'l Bldg., Wichita, Ks.

(Address)

SUBSCRIBED AND SWORN TO before me this 11th day of Dec. 19 75

Ella Priess

My commission expires 8-25-76

Ella Priess

Notary Public.

Ella Priess
STATE NOTARY PUBLIC
Sedgwick County, Kansas
My Com. Expires Aug. 25, 1976

DRILLERS' LOG

G. W. BREUER
No. 1 Young
NE NW NE, Sec. 13-18S-21W
Ness County, Kansas

Elev: 2101 K.B.

Commenced: 11-22-75
Completed: 12-1-75

Surface Casing: 310' of
8-5/8" cemented w/200 sx
common cement, 2% Gel, 3% cc.
11-22-75

<u>FORMATION</u>	<u>DEPTH.</u>
Surface Hole	0 - 318
Shale	318 - 1040
Shale & Red Bed	1040 - 1425
Shale	1425 - 1945
Shale & Lime	1945 - 2575
Lime & Shale	2575 - 3835
Lime	3835 - 4160 RTD

I do hereby certify that the foregoing statements are true and correct to the best of my knowledge and belief.

D. N. B. DRILLING, INC.

James L. Donelson
JAMES L. DONELSON

STATE OF KANSAS: ss:

Subscribed and sworn to before me this 3rd day of December 1975.

Ella Priess

Ella Priess, Notary Public

DEC 16 1975

Ella Priess
STATE NOTARY-PUBLIC
Sedgwick County, Kansas
My Com. Expires Aug. 25, 1976