


15 135 22196 0000

WELL PLUGGING RECORD

Give All Information Completely
 Make Required Affidavit

COUNTY Ness SEC. 19 TWP. 18 RGE. 21 E/W
 Location as in quarters or footage from lines:
 NW NW NE

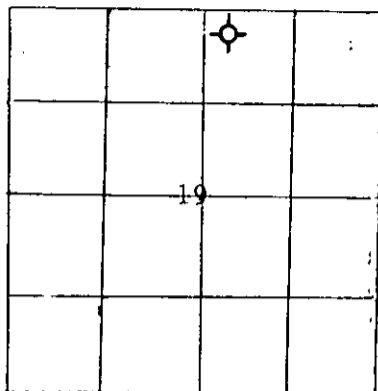

Locate Well
 correctly on above
 Section Platt.

Lease Owner Wild Boys and The Silver Bullet
 Lease Name Suppes' U' (Bad Whiskey) Well No. 7
 Office Address 807 N. Waco, Suite 3A, Wichita, Ks.
 Character of Well (Completed as Oil, Gas or Dry Hole): Dry Hole
 Date Well Completed January 24, 1982
 Application for plugging filed February 3, 1982
 Plugging commenced January 24, 1982 5:00 p.m.
 Plugging completed January 24, 1982 8:15 p.m.
 Reason for abandonment of well or producing formation Non-commercial

Was permission obtained from the Conservation Division or it's
 Agent's before plugging was commenced? Yes

Name of Conservation Agent who supervised plugging of this well Steve Durrant
 Producing formation N/A Depth to top bottom T.D. 4340
 Show depth and thickness of all water, oil and gas formations.

OIL, GAS OR WATER RECORDS

Casing Record

Formation	Content	From	To	Size	Put in	Pulled Out
Osage	SW	4303	4338	8 5/8	540	
Warsaw	SW, 550	4294	4303			

Describe in detail the manner in which the well was plugged, indicating where the mud
 fluid was placed and the method or methods used in introducing it into the hold. If cement
 or other plugs were used, state the character of same and depth placed, from feet
 to feet for each plug set.

70 sacks at 840', 40 sacks at 480', bridge plug and 10 sacks at 40' in rathole,
5 sacks in mousehold.

50/50 Pozmix + 4% Gel + 3% CaCl₂

Cement plug from 840' to 640' cement plug from 480' to 366', cement bridge plug at 40'
and cement plug from 40' to surface.

Mud fluids are left in pits and backfilled in place when sufficiently dry.

RECEIVED
 STATE CORPORATION COMMISSION
 FEB - 4 1982
 CONSERVATION DIVISION
 Wichita, Kansas

(If additional description is necessary, use BACK of this sheet)

Name of Plugging Contractor Halliburton Services

STATE OF Kansas COUNTY OF Sedgwick, ss.
R. A. Christensen (employee of owner) or (owner or operator) of the
 above-described well, being first duly sworn on oath, says: That I have knowledge of the
 facts, statements, and matters herein contained and the log of the above-described well as
 filed and that the same are true and correct. So help me God.

(Signature) R. A. Christensen

(Address)

SUBSCRIBED AND SWORN TO before me this 3rd day of February, 19 82

Donna Hale Ard
 Notary Public.

My Commission expires: October 29, 1982

DONNA HALE ARD
 STATE NOTARY PUBLIC
 SEDGWICK COUNTY, KANSAS