


STATE OF KANSAS
STATE CORPORATION COMMISSION

WELL PLUGGING RECORD

Give All Information Completely
Make Required Affidavit
Mail or Deliver Report to
Conservation Division
State Corporation Comm.
245 North Water
Wichita, KS 67202

Rice County, Sec. 9 Twp. 20 Rge. 8 E/W
Location as "NE/CNW 1/4 SW 1/4" or footage from lines
C S/2 SW NE

Lease Owner Raymond Oil Co., Inc.
Lease Name Potwin #1 Well No. _____
Office Address Wichita, Kansas
Character of Well (Completed as Oil, Gas or Dry Hole) _____

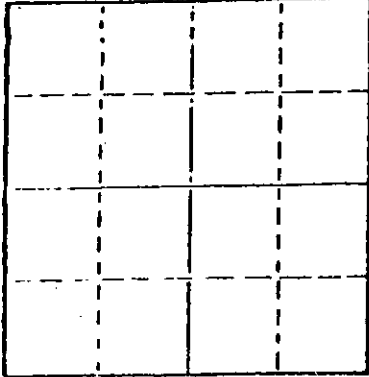

Locate well correctly on above
Section Plot

Date Well completed _____ 19____
Application for plugging filed _____ 19____
Application for plugging approved _____ 19____
Plugging commenced 12/23/77 _____ 19____
Plugging completed 12/28/77 _____ 19____
Reason for abandonment of well or producing formation _____

If a producing well is abandoned, date of last production _____ 19____
depleted.

Was permission obtained from the Conservation Division or
its agents before plugging was commenced? yes

Name of Conservation Agent who supervised plugging of this well Toman
Producing formation _____ Depth to top _____ Bottom _____ Total Depth of Well 3490
Show depth and thickness of all water, oil and gas formations.

OIL, GAS OR WATER RECORDS

CASING RECORD

FORMATION	CONTENT	FROM	TO	SIZE	PUT IN	PULLED OUT
				8-5/8	234	none
				4-1/2"	3490	2702'

Describe in detail the manner in which the well was plugged, indicating where the mud fluid was placed and the method or methods used in introducing it into the hold. If cement or other plugs were used, state the character of same and depth placed, from _____ feet to _____ feet for each plug set.

Sanded to 3400' and ran 4 sacks cement. Shot pipe at 2930', 3820', 2760', 2695', pulled 59 joints, circulated 10 sacks gel thru 4-1/2" casing at 600'. Pulled 9 joints, circulated 100 sacks cement thru 4-1/2" casing at 290'. Pulled 6 joints and circulated 50 sacks cement thru 4-1/2" casing at 90'. Pulled 3 joints and tallied pipe.

PLUGGING COMPLETE.

(If additional description is necessary, use BACK of this sheet)

Name of Plugging Contractor KELSO CASING PULLING
CHASE, KANSAS


STATE OF KANSAS COUNTY OF RICE, ss.
R. DARRELL KELSO (employee of owner) or (owner or operator)
of the above-described well, being first duly sworn on oath, says: That I have knowledge of the facts, statements, and matters herein contained and the log of the above-described well as filed and that the same are true and correct. So help me God.

(Signature) R. Darrell Kelso
CHASE, KANSAS
(Address)

SUBSCRIBED AND SWORN TO before me this 16th day of Jan., 19 78

Margaret Melcher
Notary Public.

My commission expires

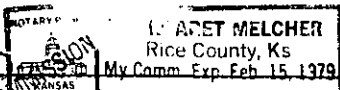

RECEIVED
STATE CORPORATION COMMISSION
JAN 18 1978
CONSERVATION DIVISION
Wichita, Kansas

W E L L L O G

HYDE - ISEARN - WELLS, POTWIN #1
C S/2 SW NE, Section 9-20S-8W
Rice County, Kansas

Figures indicate bottom of formation:

ELEVATION: 1660' KB

PIPE RECORD:

8 5/8" set @ 234'
with 200 sacks cement.
4 1/2" set @ 3490'
with 100 sacks salt sat.

ROTARY COMMENCED: April 12, 1965
ROTARY COMPLETED: April 20, 1965

TOPS:

Anhydrite 226
Heebner 2722
Brown Lime 2864
Lansing 2900
Conglomerate, Chert 3224
Kinderhook Lime 3351
Kinderhook Sand 3444
Maquoketa 3464

0 to 10 celliar
20 clay
70 sand
160 shale
235 shale & red rock
1435 shale & shells
1515 lime & Shale
2210 shale & shells
2723 lime & shale
2730 lime
3425 lime & shale
3448 shale & sand
3451 sand
3490 lime & shale
3490 rotary total depth

STATE OF KANSAS)
COUNTY OF BARTON) ss

RECEIVED
STATE CORPORATION COMMISSION
DEC 06 1977
CONSERVATION DIVISION
Wichita, Kansas

I, Dean Wells, Partner in Isearn Drilling Company, contractor for the above described well, being first-duly sworn on oath, declare: That I have knowledge of the facts, statements and matter herein contained pertaining to the log of the above-described well, as filed, and that the same are true and correct.

Dean Wells
Dean Wells, Partner

Subscribed and sworn to before me on this 23rd day of April , 1965.

George A. Meyer
George A. Meyer, Notary Public

My commission expires February 10, 1967.