

TYPE

AFFIDAVIT OF COMPLETION FORM

ACO-1 WELL HISTORY

Compt. _____

SIDE ONE

Two (2) copies of this form shall be filed with the Kansas Corporation Commission, 200 Colorado Derby Building, Wichita, Kansas 67202, within thirty (30) days after the completion of a well, regardless of how the well was completed.

(F) Attach separate letter of request if the information is to be held confidential. If confidential, only file one copy. Information on Side One will be of public record and Side Two will then be held confidential.

Applications must be made on dual completion, commingling, salt water disposal, injection and temporarily abandoned wells.

C Attach one copy only wireline logs (i.e. electrical log, sonic log, gamma ray neutron log, etc.). (Rules 82-2-105 & 82-2-125) KCC# (316) 263-3238.

LICENSE # 6030 EXPIRATION DATE June 30, 1983

OPERATOR AINSWORTH OPERATING COMPANY API NO. 15-015-22,196-00-00

ADDRESS P.O. Box 1269 COLORADO SPRINGS, CO 80901 COUNTY Butler

FIELD Edmonds-Extension

** CONTACT PERSON Pyne A. Gramly PROD. FORMATION Miss Chat
PHONE (303) 576-5300

PURCHASER Total Petroleum LEASE Ed Liggett "B"

ADDRESS P.O. Box 2244 WELL NO. 1

Wichita, KS 67201 WELL LOCATION NW NW SE

DRILLING Edco Drilling Company 330 Ft. from N Line and

CONTRACTOR Box 645 2310 Ft. from E Line of


ADDRESS El Dorado, KS 67042 the SE (Qtr.) SEC 6 TWP 23S RGE 4E

PLUGGING N/A

CONTRACTOR ADDRESS

WELL PLAT

(Office Use Only)

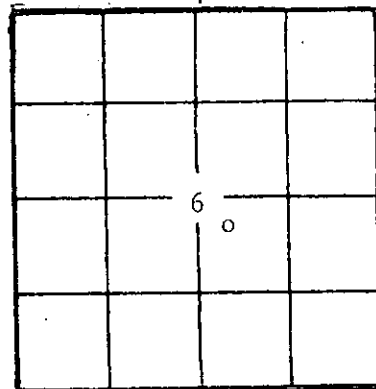

KCC
KGS

SWD/REP _____
PLG. _____

TOTAL DEPTH 2485 PBTD

SPUD DATE 12/27/82 DATE COMPLETED 12/28/82

ELEV: GR 1392 DF KB 1397'

DRILLED WITH ~~XXXXXX~~ (ROTARY) ~~XXXXX~~ TOOLS.

DOCKET NO. OF DISPOSAL OR REPRESSURING WELL BEING USED TO DISPOSE OF WATER FROM THIS LEASE N/A

Amount of surface pipe set and cemented 201' DV Tool Used? N/A

THIS AFFIDAVIT APPLIES TO: (Circle ONE) - Oil, Gas, Shut-in Gas, Dry, Disposal, Injection, Temporarily Abandoned, OWWO. Other

ALL REQUIREMENTS OF THE STATUTES, RULES AND REGULATIONS PROMULGATED TO REGULATE THE OIL AND GAS INDUSTRY HAVE BEEN FULLY COMPLIED WITH. STATE COMMISSION

JAN 17 1983

A F F I D A V I T

DIVISION DIVISION, Wichita, Kansas

Pyne A. Gramly, being of lawful age, hereby certifies that:

I am the Affiant, and I am familiar with the contents of the foregoing Affidavit. The statements and allegations contained therein are true and correct.

Pyne A. Gramly
(Name)

SUBSCRIBED AND SWORN TO BEFORE ME this 14th day of January

19 83 .

Donald Berg
(NOTARY PUBLIC)

MY COMMISSION EXPIRES: My Commission Expires Sept. 23, 1986

** The person who can be reached by phone regarding any questions concerning this information.