


WELL PLUGGING RECORD

Give All Information Completely
Make Required Affidavit
Mail or Deliver Report to:
Conservation Division
State Corporation Commission
212 No. Market
Wichita, Kansas

NORTH

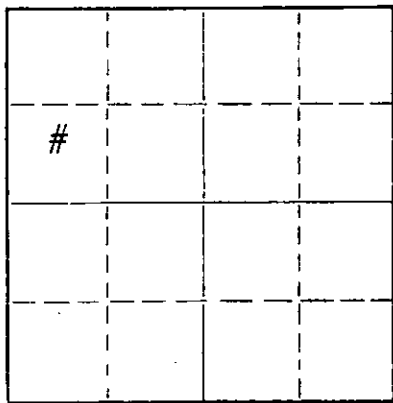

Locate well correctly on above
Section Plat

Barber County. Sec. 11 Twp. 32 Rge. 14 (E) W (W)
Location as "NE/CNWxSWx" or footage from lines. CSW NW
Lease Owner Bower Drilling Co. Inc.
Lease Name Lake "B" Well No. 1
Office Address 1434 Wichita Plaza Wichita, Ks.
Character of Well (completed as Oil, Gas or Dry Hole) Dry
Date well completed _____ 19____
Application for plugging filed _____ Apr. 17, 1968
Application for plugging approved _____ Apr. 20, 1968
Plugging commenced _____ Apr. 18, 1968
Plugging completed _____ Apr. 19, 1968
Reason for abandonment of well or producing formation _____

If a producing well is abandoned, date of last production _____ 19____
Was permission obtained from the Conservation Division or its agents before plugging was commenced? Yes

Name of Conservation Agent who supervised plugging of this well Ralph Warren
Producing formation _____ Depth to top _____ Bottom _____ Total Depth of Well _____ Feet
Show depth and thickness of all water, oil and gas formations.

OIL, GAS OR WATER RECORDS

CASING RECORD

FORMATION	CONTENT	FROM	TO	SIZE	PUT IN	PULLED OUT
				8 5/8	901'	None
				4 1/2	4548'	2638'

Describe in detail the manner in which the well was plugged, indicating where the mud fluid was placed and the method or methods used in introducing it into the hole. If cement or other plugs were used, state the character of same and depth placed, from _____ feet to _____ feet for each plug set.

Plugged back with sand from 3100' to 2830'. Mixed and dumped 4 sx. of cement from 2830' to 2782'. Pulled casing. Mudded hole to 860'. Set 10' rock bridge from 860' to 850'. Mixed and dumped 25 sx. of cement from 850' to 775'. Mudded hole from 775' to 40'. Set 10' rock bridge from 40' to 30'. Mixed and dumped 10 sx. of cement from 30' to base of the cellar.


RECEIVED
STATE CORPORATION COMMISSION
APR 26 1968
CONSERVATION DIVISION
Wichita, Kansas

(If additional description is necessary, use BACK of this sheet)

Name of Plugging Contractor Russ Casing Pulling Inc.
Address P.O. Box 1082 Great Bend, Ks.

STATE OF Kansas, COUNTY OF Sedgwick, ss.
Emil E. Bowers (owner or operator) of the above-described well, being first duly sworn on oath, says: That I have knowledge of the facts, statements, and matters herein contained and the log of the above-described well as filed and that the same are true and correct. So help me God.

(Signature) Emil E. Bowers
1434 Wichita Plaza, Wichita, Ks.
67303
(Address)

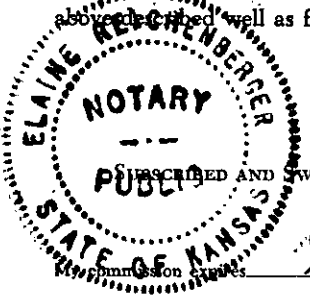

SUBSCRIBED AND SWORN TO before me this 25th day of April, 1968
Elaine Reichenberger
Notary Public.

WELL LOG

COMPANY: BOWERS DRILLING COMPANY, INC.
 CONTRACTOR: BOWERS DRILLING COMPANY, INC.
 FARM: #1 Lake "B"
 LOCATION: C E/2 SW NW, Section 11-32S-14W
 Barber County, Kansas
 COMMENCED: 3-20-68
 COMPLETED: 4-4-68
 ELEVATION: 1784 Kelly Bushing

0 - 1910	Shells & Shale	8-5/8" casing set at 901' W/500 sacks
1910 - 2089	Lime & Shale	
2089 - 2580	Lime	
2580 - 3935	Lime & Shale	
3935 - 4366	Lime	
4366 - 4475	Lime & Shale	
4475 - 4497	Lime	
4497 - 4530	Lime & Chert	
4530 - 4644	Lime	4-1/2" casing set at 4548' W/275 sacks
4644 - 4827	Lime & Chert	
4827 - 4920	Lime & Shale	
4920 -	T.D.	

LOG TOPS

Neva	2676 - 892
Indian Cave	2881 -1097
Langdon	2960 -1176
Tarkio	3079 -1295
Howard	3332 -1548
Topeka	3439 -1655
Lecompton	3596 -1802
Lecompton Gas Zone	3634 -1850
Heebner	3807 -2023
Toronto	3822 -2038
Douglas	3836 -2052
Lansing	3974 -2190
Marmaton	4397 -2613
Mississippian	4484 -2700
Kinderhook	4675 -2891
Viola	4738 -2954
Simpson	4828 -3044
Log T.D.	2920 -3136

RECEIVED
 STATE CORPORATION COMMISSION
 APR 16 1968
 CONSERVATION DIVISION
 Wichita, Kansas

STATE OF KANSAS)
) SS
 COUNTY OF SEDGWICK)

I, Emil E. Bowers, do hereby certify that the above and foregoing is a true and correct copy of the log of the #1 Lake "B" located C E/2 SW NW, Section 11-32S-14W Barber County, Kansas, as reflected by the files of Bowers Drilling Company, Inc.

Emil E. Bowers

Subscribed and sworn to before me, a Notary Public, in and for the State of Kansas, this 12th day of April, 1968.



Elaine Reichenberger
 Elaine Reichenberger, Notary Public

My Commission expires November 16, 1971.