

STATE OF KANSAS
STATE CORPORATION COMMISSION

Form CP-4

WELL PLUGGING RECORD

Give All Information Completely
Make Required Affidavit
Mail or Deliver Report to:
Conservation Division
State Corporation Commission
P. O. Box 17027
Wichita, Kansas 67217
NORTH

Barber County, Sec. 11 Twp. 32 Rge. 14 (E) W (W)

Location as "NE/CNWSW" or footage from lines C N 1/2 SW SE

Lease Owner: Bowers Drlg. Co., Inc.

Lease Name: Lake Unit Well No. # 1

Office Address: 1434 Wichita Plaza ; Wichita, Ks. 67202

Character of Well (completed as Oil, Gas or Dry Hole)

Date well completed _____ 19__

Application for plugging filed _____ December 1971

Application for plugging approved _____ December 1971


Plugging commenced _____ January 19 1972

Plugging completed _____ January 31 1972

Reason for abandonment of well or producing formation _____

If a producing well is abandoned, date of last production _____ 19__

Was permission obtained from the Conservation Division or its agents before plugging was commenced? Yes

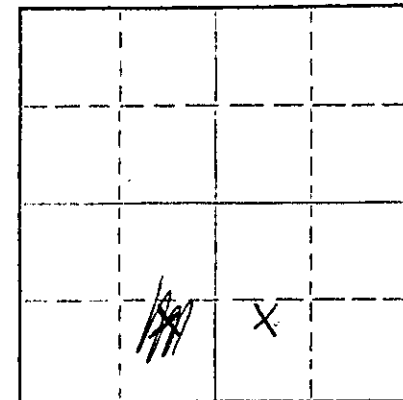

Locate well correctly on above Section Plat

Name of Conservation Agent who supervised plugging of this well: Russell Biberstein

Producing formation _____ Depth to top _____ Bottom _____ Total Depth of Well _____ Feet

Show depth and thickness of all water, oil and gas formations.

OIL, GAS OR WATER RECORDS


CASING RECORD

FORMATION	CONTENT	FROM	TO	SIZE	PUT IN	PULLED OUT
				8 5/8"	992	None
				4 1/2"	3848	3331

Describe in detail the manner in which the well was plugged, indicating where the mud fluid was placed and the method or methods used in introducing it into the hole. If cement or other plugs were used, state the character of same and depth placed, from _____ feet to _____ feet for each plug set.

January 19, 1972 Plugged off bottom. Dumped sand to 3500'. Mixed and dumped 4 sx of cement.

January 31, 1972 Plugged off top. Set 10' rock bridge at 270'. Filled 8 5/8" surface casing from 270' to base of cellar with 3000 lb. P.S.I. ready-mix concrete.

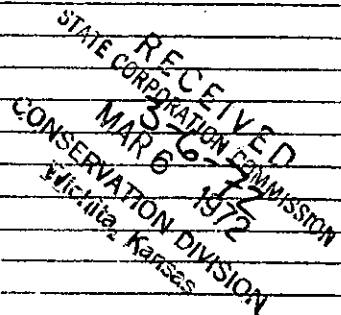


Name of Plugging Contractor: RUSS CASING PULLING, INC.
Address: P. O. BOX 1082 ; GREAT BEND, KANSAS 67530

STATE OF KANSAS, COUNTY OF SEDGWICK, ss. Emil E. Bowers (employee of owner) or (owner or operator) of the above-described

well, being first duly sworn on oath, says: That I have knowledge of the facts, statements, and matters herein contained and the log of the above-described well as filed and that the same are true and correct. So help me God.

(Signature) Emil E. Bowers
125 W. Market, Suite 1425 (Address)

Subscribed and sworn to before me this 3rd day of March, 1972.

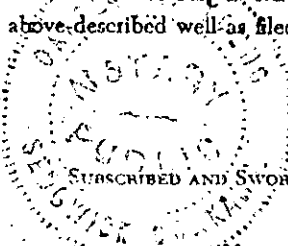

Carol A. Young, Notary Public.

My commission expires May 12, 1973