


STATE OF KANSAS  
STATE CORPORATION COMMISSION

Give All Information Completely  
Make Required Affidavit  
Mail or Deliver Report to:  
Conservation Division  
State Corporation Commission  
212 No. Market  
Wichita, Kansas

WELL PLUGGING RECORD

Barber County, Sec. 11 Twp. 32S Rge. 14 (E) (W)X  
Location as "NE/CNWxSWx" or footage from lines C SE NE  
Lease Owner Bowers Drilling Co., Inc.  
Lease Name Lake "D" Well No. 1  
Office Address 125 North Market, Suite 1434, Wichita, Kansas  
Character of Well (completed as Oil, Gas or Dry Hole) Dry Hole  
Date well completed 1-18 1971  
Application for plugging filed 1-18 1971  
Application for plugging approved 1-18 1971  
Plugging commenced 1-18 1971  
Plugging completed 1-18 1971  
Reason for abandonment of well or producing formation Dry Hole

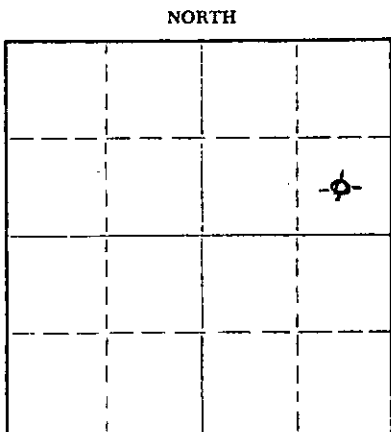

Locate well correctly on above  
Section Plat

If a producing well is abandoned, date of last production 19  
Was permission obtained from the Conservation Division or its agents before plugging was commenced? Yes - telephone

Name of Conservation Agent who supervised plugging of this well G. Russell Biberstein  
Producing formation \_\_\_\_\_ Depth to top \_\_\_\_\_ Bottom \_\_\_\_\_ Total Depth of Well 4068' Feet  
Show depth and thickness of all water, oil and gas formations. Wash down to 3620'

OIL, GAS OR WATER RECORDS

CASING RECORD

FORMATION	CONTENT	FROM	TO	SIZE	PUT IN	PULLED OUT

Describe in detail the manner in which the well was plugged, indicating where the mud fluid was placed and the method or methods used in introducing it into the hole. If cement or other plugs were used, state the character of same and depth placed, from \_\_\_\_\_ feet to \_\_\_\_\_ feet for each plug set.

Filled with heavy mud from 4068' to 300'  
Plug with 25 saks' cem. @ 300'.  
Mud to 40';  
Plug with 10 saks cem. @ 40';  
Mud to surface.

RECEIVED  
STATE CORPORATION COMMISSION  
1-27-71  
JAN 27 1971  
CONSERVATION DIVISION  
Wichita, Kansas

(If additional description is necessary, use BACK of this sheet)

Name of Plugging Contractor Bowers Drilling Company, Inc.  
Address 125 North Market, Suite 1434, Wichita, Kansas 67202


STATE OF KANSAS COUNTY OF SEDGWICK, ss.  
Emil E. Bowers, President

(employee or operator) of the above-described well, being first duly sworn on oath, says: That I have knowledge of the facts, statements, and matters herein contained and the log of the above-described well as filed and that the same are true and correct. So help me God.

(Signature) Emil E. Bowers  
125 North Market, Suite 1434, Wichita, Kansas  
(Address).

SUBSCRIBED AND SWORN TO before me this 26th day of January, 1971

My commission expires May 12, 1973

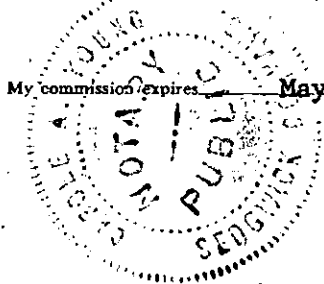

Carol J. Young Notary Public.