


STATE OF KANSAS  
STATE CORPORATION COMMISSION

WELL PLUGGING RECORD

Give All Information Completely  
Make Required Affidavit  
Mail or Deliver Report to:  
Conservation Division  
State Corporation Commission

P. O. Box 17027  
Wichita, Kansas 67217  
NORTH

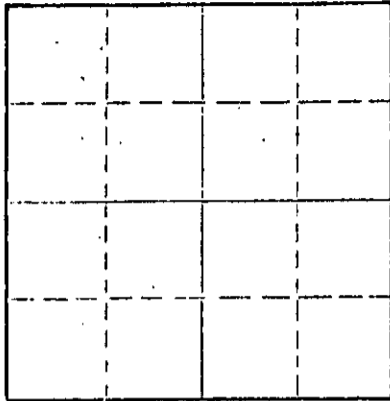

Locate well correctly on above  
Section Plat

Barber County, Sec. 32 Twp. 32S Rge. (X) 14 (W)  
Location as "NE/CNW&SW" or footage from lines. C NW SW  
Lease Owner Beacon Resources, Inc.  
Lease Name Schooley Well No. 1  
Office Address 1000 Century Plaza, Wichita, Kansas 67202  
Character of Well (completed as Oil, Gas or Dry Hole) Dry Hole  
Date well completed January 19, 19 73  
Application for plugging filed January 19, 19 73  
Application for plugging approved January 19, 19 73  
Plugging commenced January 19, 19 73  
Plugging completed January 19, 19 73  
Reason for abandonment of well or producing formation

If a producing well is abandoned, date of last production 19  
Was permission obtained from the Conservation Division or its agents before plugging was commenced? Yes

Name of Conservation Agent who supervised plugging of this well G. R. Biberstein  
Producing formation Depth to top Bottom Total Depth of Well 4845 Feet  
Show depth and thickness of all water, oil and gas formations.

OIL, GAS OR WATER RECORDS

CASING RECORD

FORMATION	CONTENT	FROM	TO	SIZE	PUT IN	PULLED OUT
				8-5/8"	266'	None

Describe in detail the manner in which the well was plugged, indicating where the mud fluid was placed and the method or methods used in introducing it into the hole. If cement or other plugs were used, state the character of same and depth placed, from feet to feet for each plug set.  
Mudded up with heavy mud to 250 feet. Followed by wooden plug and 1/2 sack hulls. Placed 25 sacks cement onto hulls. Mudded up with heavy mud to 40 feet followed by wooden plug, 1/2 sack hulls and 10 sacks cement to base of well cellar. Plugged rat hole with 2 sacks cement.

RECEIVED  
STATE CORPORATION COMMISSION  
FEB 22 1973  
CONSERVATION DIVISION  
Wichita, Kansas

(If additional description is necessary, use BACK of this sheet)  
Name of Plugging Contractor Graves Drilling Co., Inc.  
Address 505 Union Center, Wichita, Kansas 67202

STATE OF KANSAS COUNTY OF SEDGWICK ss.  
John C. Graves (employee of owner) or (owner or operator) of the above-described well, being first duly sworn on oath, says: That I have knowledge of the facts, statements, and matters herein contained and the log of the above-described well as filed and that the same are true and correct. So help me God.

(Signature) *John C. Graves*  
505 Union Center, Wichita, Kansas 67202  
(Address)

SUBSCRIBED AND SWORN to before me this 21st day of February 19 73  
Betty Brandt  
Notary Public.  
My commission expires May 9, 1975

ROTARY DRILLERS' LOG

OPERATOR: Beacon Resources, Inc. DRILLING COMMENCED: January 7, 1973  
 1000 Century Plaza  
 Wichita, Kansas 67202

CONTRACTOR: Graves Drilling Co., Inc. DRILLING COMPLETED: January 19, 1973  
 505 Union Center  
 Wichita, Kansas 67202

CASING RECORD: 6 Jts. 266' 8-5/8" LOCATION: Schooley No. 1  
 cemented with 275 sacks C NW SW  
 Section 32-32S-14W  
 Barber County, Kansas

0 - 55 Sod & red bed  
 55 - 615 Red bed & shale  
 615 - 1750 Shale  
 1750 - 2011 Shale & lime  
 2011 - 2750 Lime  
 2750 - 4110 Lime & shale  
 4110 - 4233 Shale  
 4233 - 4765 Lime  
 4765 - 4790 Lime & shale  
 4790 - 4805 Chert  
 4805 - 4820 Chert & lime  
 4820 - 4845 Lime  
 4845 Rotary Total Depth

RECEIVED  
 STATE CORPORATION COMMISSION  
 FEB 22 1973  
 2-22-73  
 CONSERVATION DIVISION  
 Wichita, Kansas

I hereby certify the foregoing statements to be true and correct to the best of my knowledge.

GRAVES DRILLING CO., INC.

By John Graves President

STATE OF KANSAS )  
 ) ss.  
 SEDGWICK COUNTY )

Subscribed and sworn to before me, a Notary Public, this 21st of February, 1973.

Betty Brandt  
 Betty Brandt Notary Public

My commission expires:  
 May 9, 1975