


STATE OF KANSAS  
STATE CORPORATION COMMISSION

Give All Information Completely  
Make Required Affidavit  
Mail or Deliver Report to:  
Conservation Division  
State Corporation Commission  
212 No. Market  
Wichita, Kansas

WELL PLUGGING RECORD

Barber County, Sec. 30 Twp. 32 Rge. 14 (W)

Location as "NE/CNW/SW" or footage from lines NW NW  
Lease Owner Beardmore Oil Inc.  
Lease Name Cline-Mills Well No. 2  
Office Address 700 - One Twenty Bldg., Wichita, Kansas  
Character of Well (completed as Oil, Gas or Dry Hole) Dry Hole  
Date well completed 1-27 1970  
Application for plugging filed 1-27 1970  
Application for plugging approved 1-27 1970  
Plugging commenced 1-27 1970  
Plugging completed 1-27 1970  
Reason for abandonment of well or producing formation Dry Hole

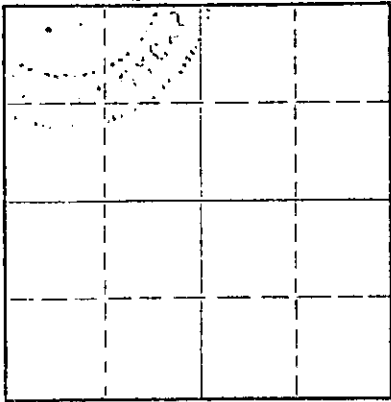

Locate well correctly on above Section Plat

If a producing well is abandoned, date of last production 19  
Was permission obtained from the Conservation Division or its agents before plugging was commenced? Yes

Name of Conservation Agent who supervised plugging of this well Harold Biberstein, Attica, Kansas  
Producing formation \_\_\_\_\_ Depth to top \_\_\_\_\_ Bottom \_\_\_\_\_ Total Depth of Well 4511 Feet  
Show depth and thickness of all water, oil and gas formations.

OIL, GAS OR WATER RECORDS


CASING RECORD

FORMATION	CONTENT	FROM	TO	SIZE	PUT IN	PULLED OUT
				13-3/8"	35	
				8-5/8"	282	

Describe in detail the manner in which the well was plugged, indicating where the mud fluid was placed and the method or methods used in introducing it into the hole. If cement or other plugs were used, state the character of same and depth placed, from \_\_\_\_\_ feet to \_\_\_\_\_ feet for each plug set.

- 0 to 40' - 10 sacks cement
- 40' - wood plug
- 40' to 165' - heavy mud
- 165' to 240' - 25 sacks cement
- 240' - wood plug
- 240' to 4511' - heavy mud

Also: 2 sacks cement in rat hole.

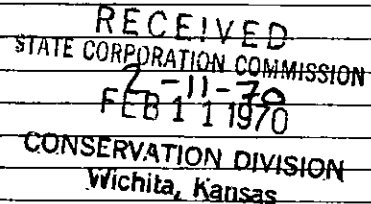

(If additional description is necessary, use BACK of this sheet)

Name of Plugging Contractor Gabbert-Jones, 830 Sutton Place, Wichita, Kansas  
Address \_\_\_\_\_

STATE OF Kansas, COUNTY OF Sedgwick, ss.  
Heber Beardmore (XXXXXX owner or operator) of the above-described well, being first duly sworn on oath, says: That I have knowledge of the facts, statements, and matters herein contained and the log of the above-described well as filed and that the same are true and correct. So help me God.

(Signature) Heber Beardmore  
700 - 120 Bldg., Wichita, Kansas  
(Address)

Subscribed and Sworn to before me this 9th day of February, 1970



Shirley Ann Jackson  
Notary Public.

15-007-20093-00-01

GABBERT-JONES, INC.  
WICHITA, KANSAS  
DRILLERS' WELL LOG

CLINE-MILLS #2 - OWWO  
C NW NW Section 30-32S-14W  
Barber County, Kansas

OLD INFORMATION:

OPERATOR - Beardmore Drilling Co.  
Spud 3/30/69, TD 4854', D & A on 4/12/69

NEW INFORMATION:

Commenced: January 23, 1970  
Completed: January 27, 1970

OPERATOR - Beardmore Oil, Inc.

RECEIVED  
STATE CORPORATION COMMISSION  
2-24-70  
FEB 24 1970  
CONSERVATION DIVISION  
Wichita, Kansas

DEPTH		FORMATION	REMARKS
From	To		
0	4511	Mud and cement	Wash down
4511	TD		Dry and abandoned

I, E. E. HALL, certify this is a correct copy of the Drillers' Log for the well washed down in the C NW NW Section 30-32S-14W, Barber County, Kansas, to the best of my knowledge and belief.

*E. E. Hall*  
E. E. HALL

STATE OF KANSAS )  
                          ) SS  
COUNTY OF SEDGWICK )

Before me, the undersigned, a Notary Public within and for said County and State, on this 3 day of February, 1970, personally appeared E. E. Hall to me personally known to be the identical person who executed the within and foregoing instrument and acknowledged to me that he executed the same as his free and voluntary act and deed for the uses and purposes therein set forth.

IN WITNESS WHEREOF, I have hereunto set my hand and official seal the day and year last above written.

My Commission Expires Feb. 1, 1972

*Barbara J. Layton*  
Barbara J. Layton, Notary Public

