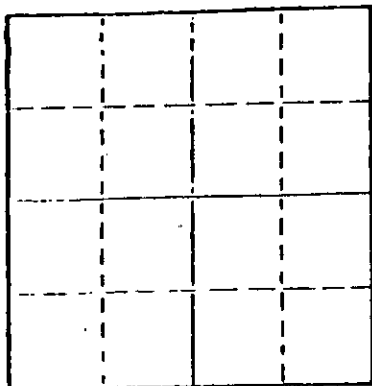


STATE OF KANSAS
STATE CORPORATION COMMISSION

WELL PLUGGING RECORD

Give All Information Completely
Make Required Affidavit
Mail or Deliver Report to
Conservation Division
State Corporation Comm.
245 North Water
Wichita, KS 67202

Locate well correctly on above
Section Plat

Barber County. Sec. 30 Twp. 32 S Rge. 14 E/W
Location as "NE/CNW $\frac{1}{4}$ SW $\frac{1}{4}$ " or footage from lines
C - NW SE
Lease Owner Texas Oil and Gas
Lease Name Cline Mills Well No. A - 1
Office Address 200 W Douglas, Suite 300, Wichita, Ks. 67202
Character of Well (Completed as Oil, Gas or Dry Hole)
Gas
Date Well completed 19
Application for plugging filed 19
Application for plugging approved 19
Plugging commenced 7-25 19 78
Plugging completed 7-27 19 78
Reason for abandonment of well or producing formation
Dry
If a producing well is abandoned, date of last production 19

Was permission obtained from the Conservation Division or
its agents before plugging was commenced? Yes

Name of Conservation Agent who supervised plugging of this well Bill Owens
Producing formation Depth to top Bottom Total Depth of Well 4324
Show depth and thickness of all water, oil and gas formations.

OIL, GAS OR WATER RECORDS

CASING RECORD

FORMATION	CONTENT	FROM	TO	SIZE	PUT IN	PULLED OUT
				8 5/8	287	None
				4 1/2"	4285	3006

Describe in detail the manner in which the well was plugged, indicating where the mud fluid
was placed and the method or methods used in introducing it into the hold. If cement or other
plugs were used, state the character of same and depth placed, from feet to
feet for each plug set.

Sand from 4195 to XXX 4134. 4 sacks cement from 4134 to 4100. Ripped and
pulled 3006. Built bridge at 310. Rock to 300. 5 yards of ready mix.

RECEIVED
STATE CORPORATION COMMISSION

AUG 10 1978
8-10-78
CONSERVATION DIVISION
Wichita, Kansas

(If additional description is necessary, use BACK of this sheet)

Name of Plugging Contractor Clarke Corporation

STATE OF Kansas COUNTY OF Barber, ss.
Elmer R. Maramba (employee of owner) or (owner or operator)
of the above-described well, being first duly sworn on oath, says: That I have knowledge of
the facts, statements, and matters herein contained and the log of the above-described well
as filed and that the same are true and correct. So help me God.

(Signature)

Elmer R. Maramba
Medicine Lake, Kansas
(Address)

SUBSCRIBED AND SWORN TO before me this 3rd day of August, 1978.

Jessie Hamilton
Notary Public.

My commission expires

April 4, 1982

15-007-2007-00-01
KANSAS GEOLOGICAL SOCIETY
KANSAS WELL LOG BUREAU - KANSAS WELL SAMPLE BUREAU
KANSAS GEOLOGICAL SOCIETY BUILDING
508 EAST MURDOCK - WICHITA, KANSAS


COMPANY Texas-Oil And Gas Company

SEC. 30 T. 32S R. 14W
LOC. NW SE

FARM Cline-Mills "A" NO. 1 (OWWO)

TOTAL DEPTH 5,177' by prior operator
COMM. November 3, 1977 COMP. November 6, 1977
SHOT OR TREATED
CONTRACTOR H-30, Inc.
ISSUED November 18, 1977

COUNTY Barber
KANSAS

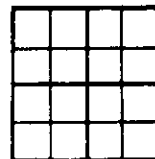

CASING
20 10
15 8-5/8" 287' cemented w/225 sxs cement ELEVATION 1,955' K.B.
12 6 (by prior operator)
13 4-1/2" 4,285' cemented w/225 sxs cement PRODUCTION
FIGURES INDICATE BOTTOM OF FORMATIONS

Washed down to

4,324'

Rotary Total Depth

5,177'

I hereby certify the above and foregoing to be
a true and correct log of the above described
well as shown by the drilling reports.

H-30, Inc.

Dean Britting
Dean Britting

State of Kansas }
County of Sedgwick } ss:

Suscribed and sworn to before me a Notary Public
in and for said county and state this 17th day of
November, 1977

Elsie Willison
Elsie Willison - Notary Public

My Commission Expires:

June 30, 1978

RECEIVED
STATE CORPORATION COMMISSION
JUL 06 1978
7-6-78
CONSERVATION DIVISION
Wichita, Kansas

PLINE-MILLS "A" #1 15-007-20027-00-01

NW SE SEC 30-32S-14W
BARBER Co., KS

ELEV. 1947 G.L.
1955 K.B.

8 5/8" set @ 278' K.B.

RECEIVED
STATE CORPORATION COMMISSION

JUL 06 1978
7-6-78
CONSERVATION DIVISION
Wichita, Kansas

CMT TOP @ ± 3385' K.B.

ports
← 5 4144-50

CIBP @ 4195'

~~P.B.T.D. 4256' K.B.~~

4 1/2", 10.5", K-55 csq set @ 4285'
Cmt w/225 SXS