


WELL PLUGGING RECORD

Give All Information Completely
Make Required Affidavit
Mail or Deliver Report to:
Conservation Division
State Corporation Commission
800 Biting Building
Wichita, Kansas

NORTH

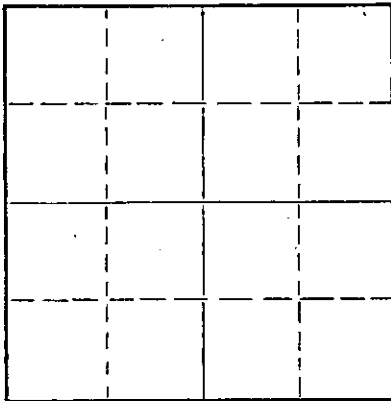

Locate well correctly on above
Section Plat

Harper County, Sec. 6 Twp. 33 Rge. (E) 6 (W)
Location as "NE/CNWxSWx" or footage from lines NE NE NE
Lease Owner Musgrove Petroleum Corporation
Lease Name HAYTER Well No. 1
Office Address 518 Petroleum Building, Wichita, Kansas.
Character of Well (completed as Oil, Gas or Dry Hole) Dry hole
Date well completed November 21, 19 54
Application for plugging filed verbally 11-21-54 Written 11-29 19 54
Application for plugging approved verbally 11-21-54, written 11-22 19 54
Plugging commenced November 21, 19 54
Plugging completed November 21, 19 54
Reason for abandonment of well or producing formation Dry hole

If a producing well is abandoned, date of last production 19
Was permission obtained from the Conservation Division or its agents before plugging was commenced? Yes

Name of Conservation Agent who supervised plugging of this well Mr. Ruel Durkee, Box 597, McPherson, Kansas.
Producing formation Depth to top Bottom Total Depth of Well 4995 Feet
Show depth and thickness of all water, oil and gas formations.

OIL, GAS OR WATER RECORDS

CASING RECORD

FORMATION	CONTENT	FROM	TO	SIZE	PUT IN	PULLED OUT
				8-5/8"	206'	

Describe in detail the manner in which the well was plugged, indicating where the mud fluid was placed and the method or methods used in introducing it into the hole. If cement or other plugs were used, state the character of same and depth placed, from feet to feet for each plug set.

Filled hole with heavy mud to 210'.
Set 1st plug at 210' w/15 sx cement.
Filled hole with heavy mud to 25'.
Set 2nd plug at 25' w/5 sx cement.

(If additional description is necessary, use BACK of this sheet)

Name of Plugging Contractor Musgrove Petroleum Corporation,
Address 518 Petroleum Building, Wichita, Kansas.

STATE OF Kansas COUNTY OF Sedgwick
I, Gordon L. Koelling (employee of owner) or (owner/operator) of the above-described well, being first duly sworn on oath, says: That I have knowledge of the facts, statements, and matters herein contained and the log of the above-described well as filed and that the same are true and correct. So help me God.

(Signature) Gordon L. Koelling
518 Petroleum Building, Wichita, Kansas.
(Address)

SUBSCRIBED AND SWORN TO before me this 29th day of November 19 54

Thelma L. Steincamp
Notary Public.

My commission expires September 24, 1956.

12-01-54

PLUGGING
FILE SEC 6 T 33 R 6 W
BOOK PAGE 29 LINE 8

CONTRACTOR'S WELL LOG

COMPANY:	Musgrove Petroleum Corporation
CONTRACTOR:	MUSgrove Petroleum Corporation
FARM:	HAYTER #1
LOCATION:	NE NE NE, Sec. 6-33-6W Harper County, Kansas.
COMMENCED:	October 28, 1954
COMPLETED:	November 21, 1954

0	210	Blue and red shale
210	1087	Shale.
1087	1133	Anhydrite
1133	1315	Shale & anhydrite
1315	1470	Shale & shells
1470	1495	Lime & shale
1495	1680	Lime
1680	2438	Lime & shale
2438	2510	Shale & shells
2510	3015	Lime & shale
3015	3144	Sand
3144	3163	Shale
3163	3324	Shale & lime
3324	3535	Shale
3543	3643	Sand & shale
3643	4370	Lime & shale
4370	4427	Lime & chert
4427	4698	Mississippi lime
4698	4795	Lime & shale
4795	4945	Simpson sand
4945	4995	Arbuckle
	4995	Rotary Total Depth

Set 8-5/8" surface pipe at 206' with 150 sacks cement.

Dry and Abandoned.

STATE OF KANSAS)
) SS
COUNTY OF SEDGWICK)

I, Gordon L. Koelling, do hereby certify that the above and foregoing is a true and correct copy of the log of the HAYTER #1, NE NE NE, Section 6-33-6 West, Harper County, Kansas, as reflected by the files of the Musgrove Petroleum Corporation.

MUSGROVE PETROLEUM CORPORATION

BY Gordon L. Koelling
Secretary-Treasurer

Subscribed and sworn to before me, a Notary Public, in and for Sedgwick County, Kansas, this 29th day of November, 1954.

Helmut Stumpp
Notary Public

My commission expires September 24, 1956.

PLUGGING
WELL SEC 6 T 33 R 6W
BOOK PAGE 22 LET 8