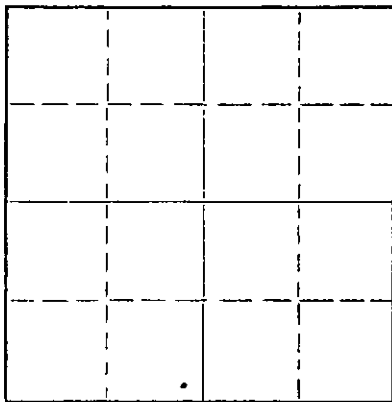


Give All Information Completely  
Make Required Affidavit  
Mail or Deliver Report to:  
Conservation Division  
State Corporation Commission  
211 No. Broadway  
Wichita, Kansas

## WELL PLUGGING RECORD

NORTH

Locate well correctly on above  
Section Plat

Ness County. Sec. 17 Twp. 18S Rge. (E) 2(W)  
Location as "NE/CNW/SW" or footage from lines SE SE SW  
Lease Owner Leben Drilling, Inc.  
Lease Name Gaede Well No. 1  
Office Address 905 Central Building, Wichita, Ks.  
Character of Well (completed as Oil, Gas or Dry Hole) Dry Hole  
Date well completed July 21 1956  
Application for plugging filed July 21 1956  
Application for plugging approved July 21 1956  
Plugging commenced July 21 1956  
Plugging completed July 21 1956  
Reason for abandonment of well or producing formation Dry Hole

If a producing well is abandoned, date of last production 19\_\_\_\_  
Was permission obtained from the Conservation Division or its agents before plugging was commenced? Yes

Name of Conservation Agent who supervised plugging of this well R. M. Brundage, Hoisington, Kansas  
Producing formation \_\_\_\_\_ Depth to top \_\_\_\_\_ Bottom \_\_\_\_\_ Total Depth of Well 4357 Feet  
Show depth and thickness of all water, oil and gas formations.

## OIL, GAS OR WATER RECORDS

## CASING RECORD

| FORMATION | CONTENT | FROM | TO | SIZE  | PUT IN | PULLED OUT |
|-----------|---------|------|----|-------|--------|------------|
|           |         |      |    | 8 5/8 | 241'   |            |
|           |         |      |    |       |        |            |
|           |         |      |    |       |        |            |
Describe in detail the manner in which the well was plugged, indicating where the mud fluid was placed and the method or methods used in introducing it into the hole. If cement or other plugs were used, state the character of same and depth placed, from \_\_\_\_\_ feet to \_\_\_\_\_ feet for each plug set.

Rotary mud w/ 1/3 sk. hulls to 217' - plug w/ 20 sks. cement through drill pipe. Rotary mud w/ 1/3 hulls and plug w/ 10 sks. cement to surface.

(If additional description is necessary, use BACK of this sheet)

Name of Plugging Contractor Leben Drilling, Inc.  
Address 905 Central Building, Wichita, Kansas

STATE OF Kansas, COUNTY OF Sedgwick, ss.  
Frank Hamlin (employee of owner) of the above-described well, being first duly sworn on oath, says: That I have knowledge of the facts, statements, and matters herein contained and the log of the above-described well as filed and that the same are true and correct. So help me God.

(Signature)

Frank Hamlin

905 Central Building, Wichita, Ks.  
(Address)

SUBSCRIBED AND SWORN TO before me this 25th day of July, 1956

My commission expires July 10, 1957

G. J. Thomas

Notary Public.

PLUGGING  
FILE SEC 17 T 18 R 21W  
BOOK PAGE 83 LINE 1

RECEIVED  
STATE CORPORATION COMMISSION  
JUL 26 1956  
7-26-56  
CONSERVATION DIVISION  
Wichita, Kansas

# CONTRACTOR'S WELL LOG

15.135.00554.0000

COMPANY:  
CONTRACTOR:  
FARM:  
LOCATION:

Leben Drilling, Inc.  
Leben Drilling, Inc.  
Gaede #1  
SE SE SW 17-18S-21W  
Ness County, Kansas  
July 10, 1956  
July 21, 1956

COMMENCED:  
COMPLETED

0 25  
25 90  
90 340  
340 515  
515 774  
774 940  
940 1123  
1123 1334  
1334 1448  
1448 1472  
1472 1510  
1510 1820  
1820 2055  
2055 2190  
2190 2263  
2263 3122  
3122 3467  
3467 3730  
3730 4103  
4103 4148  
4148 4205  
4205 4225  
4225 4295  
4295 4357  
4357

Surface Clay  
Sand and Gravel  
Shale and Shells  
Sand  
Shale and Shells  
Shale  
Sand  
Shale and Red Bed  
Shale  
Anhydrite  
Shale and Lime  
Shale and Shells  
Shale and Lime  
Shale and Lime  
Lime  
Lime and Shale  
Shale and Lime  
Lime and Shale  
Lime  
Lime and Shale  
Lime and Shale  
Sand  
Lime and Shale  
Lime  
Rotary Total Depth, D & A

Set 8 5/8" Surface Casing at 241' w/ 18" sks cement w/3 Ca. Cl.

State of Kansas )  
County of Sedgwick) ss:

I, Frank Hamlin, do hereby certify that the above and foregoing is a true and correct copy of the log of the Gaede #1, SE SE SW Section 17-18S-21W, Ness County, Kansas, as reflected by the files of Leben Drilling, Inc...

Frank Hamlin

Subscribed and Sworn to before me, a Notary Public, in and for Sedgwick County, Kansas, this 25th day of July, 1956.

Jean Thomas  
(Notary Public) D

My commission expires July 10, 1957.

|          |         |      |     |
|----------|---------|------|-----|
| PLUGGING |         |      |     |
| FILE     | SEC 17  | T 18 | 21W |
| BOOK     | PAGE 83 | LINE | 1   |

