


STATE OF KANSAS
STATE CORPORATION COMMISSION

WELL PLUGGING RECORD

15/35-22/66-0000

Give All Information Completely
Make Required Affidavit
Mail or Deliver Report to
Conservation Division
State Corporation Comm.
245 North Water
Wichita, KS 67202

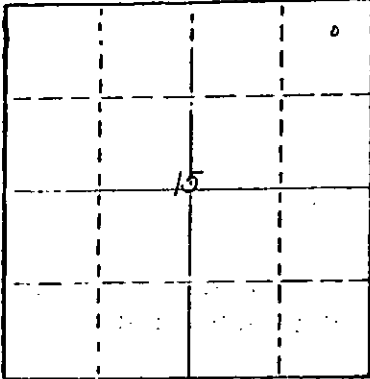

Locate well correctly on above
Section Plot

Ness County, Sec. 15 Twp. 18S Rge. 21W E/W
Location as "NE/CNW $\frac{1}{4}$ SW $\frac{1}{4}$ " or footage from lines
NE/NE/NE
Lease Owner Galloway Drilling Co., Inc.
Lease Name Fritz-Rowe Well No. 1
Office Address 105 So. Broadway, Wichita, KS 67202
Character of Well (Completed as Oil, Gas or Dry Hole)

Dry Hole

Date Well completed 11/19/81 19
Application for plugging filed 11/19/81 19
Application for plugging approved 11/19/81 19
Plugging commenced 11/10/81 19
Plugging completed 11/19/81 19
Reason for abandonment of well or producing formation

Dry Hole

If a producing well is abandoned, date of last production
n/a 19

Was permission obtained from the Conservation Division or
its agents before plugging was commenced? Yes

Name of Conservation Agent who supervised plugging of this well Leo Massey
Producing formation Depth to top Bottom Total Depth of Well 4265
Show depth and thickness of all water, oil and gas formations.

OIL, GAS OR WATER RECORDS

CASING RECORD

FORMATION	CONTENT	FROM	TO	SIZE	PUT IN	PULLED OUT
				8 5/8	348.72	none

Describe in detail the manner in which the well was plugged, indicating where the mud fluid was placed and the method or methods used in introducing it into the hold. If cement or other plugs were used, state the character of same and depth placed, from feet to feet for each plug set.

Ran 9 jts used 28# csg, set 348.72' w/225 sxs common cement + 3% Gal Ch.
+2% Gel. POB 6:40 A.M. 11/10/81 Cement circ.

(If additional description is necessary, use BACK of this sheet)

Name of Plugging Contractor Allied Cementing
Box 31, Russell, KS

STATE OF Kansas COUNTY OF Sedgwick ss:
Jay H. Galloway

(employee of owner) or (owner or operator) of the above-described well, being first duly sworn on oath, says: That I have knowledge of the facts, statements, and matters herein contained and the log of the above-described well as filed and that the same are true and correct. So help me God.

(Signature)

Jay H. Galloway

340 Broadway Plaza Bldg., Wichita, KS

Subscribed and Sworn to before me this 24 day of November 1981

My commission expires Sept. 7, 1985

Earlene M. Lumry

Notary Public.

EARLENE M. LUMRY
STATE NOTARY PUBLIC
SEDGWICK COUNTY, KANSAS
MY APPT. EXP.

RECEIVED
STATE CORPORATION COMMISSION

NOV 25 1981

CONSERVATION DIVISION
Wichita, Kansas