

This form shall be filed in duplicate with the Kansas Corporation Commission, 200 Colorado Derby Building, Wichita, Kansas 67202, within ten days after the completion of the well, regardless of how the well was completed.

Attach separate letter of request if the information is to be held confidential. If confidential, only file one copy. Information on side one will be of public record and side two will then be held confidential.

Circle one: Oil, Gas, (Dry), SWD, OWWO, Injection. Type and complete ALL sections.

Applications must be filed for dual completion, commingling, SWD and injection, T.A.

Attach wireline logs (i.e. electrical log, sonic log, gamma ray neutron log, etc.).

KCC # (316) 263-3238. (Rules 82-2-105 & 82-2-125)

OPERATOR Murfin Drilling Company

API NO. 15-007-21,438-0000

ADDRESS 617 Union Center Bldg.

COUNTY Barber

Wichita, KS 67202

FIELD Wildcat

**CONTACT PERSON Ramona Gunn

PROD. FORMATION _____

PHONE 316-267-3241

LEASE Cline-Mills

PURCHASER _____

WELL NO. 1-30

ADDRESS _____

WELL LOCATION NW SE NW

DRILLING Murfin Drilling Company

1650 Ft. from South Line and

CONTRACTOR

1650 Ft. from West Line of

ADDRESS 617 Union Center Bldg.

the SEC. 30 TWP. 32S RGE. 14W

Wichita, KS 67202


WELL FLAT

PLUGGING Murfin Drilling Company

CONTRACTOR

ADDRESS 617 Union Center Bldg.

Wichita, KS 67202

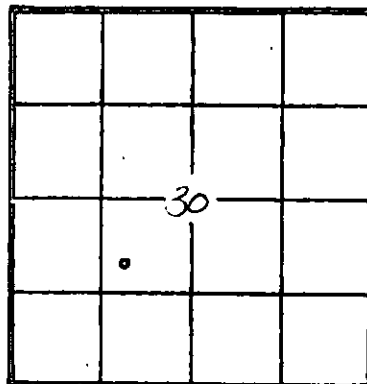

KCC ☒
KGS ☐
(Office Use)

TOTAL DEPTH 5200' PBD _____

SPUD DATE 5-1-82 DATE COMPLETED 5-17-82

ELEV: GR 1982 DF _____ KB 1991

DRILLED WITH ~~XXXXXX~~ (ROTARY) ~~XXXXX~~ TOOLS

Amount of surface pipe set and cemented 348' DV Tool Used? No

A F F I D A V I T

STATE OF KANSAS, COUNTY OF SEDGWICK SS, I, _____

David L. Murfin OF LAWFUL AGE, BEING FIRST DULY SWORN UPON HIS OATH,

DEPOSES THAT HE IS Drilling Manager (FOR)(OF) Murfin Drilling Company

OPERATOR OF THE Cline-Mills LEASE, AND IS DULY AUTHORIZED TO MAKE

THIS AFFIDAVIT FOR AND ON THE BEHALF OF SAID OPERATOR, THAT WELL NO. 1-30 ON

SAID LEASE HAS BEEN COMPLETED AS OF THE 17th DAY OF May, 19 82, AND THAT

ALL INFORMATION ENTERED HEREIN WITH RESPECT TO SAID WELL IS TRUE AND CORRECT.

FURTHER AFFIANT SATH NOT
JUN 25 1982
6-25-82
STATE CORPORATION COMMISSION
CONSERVATION DIVISION
Wichita Kansas

SUBSCRIBED AND SWORN BEFORE ME THIS 28th DAY OF May, 19 82.

RAMONA GUNN
STATE NOTARY PUBLIC
Sedgwick county, Kansas
My Not. Exp. 2-25-84

MY COMMISSION EXPIRES: 1-25-84

David L. Murfin
Ramona Gunn
NOTARY PUBLIC

**The person who can be reached by phone regarding any questions concerning this information. Within 45 days of completion, a witnessed initial test by the Commission is required if the well produces more than 25 BOPD or is located in a Basic Order Pool.