

CORRECTED
CARD MUST BE TYPED

CARL

State of Kansas
NOTICE OF INTENTION TO DRILL
(see rules on reverse side)

Collection
CARD MUST BE SIGNED
5-17-85

Starting Date: May 15, 1985
month day year

API Number 15- 077-21090 - 0000

OPERATOR: License # 5039
Name Attica Gas Venture Corp.
Address 123 North Main
City/State/Zip Attica, KS 67009
Contact Person Carl Durr
Phone 316-254-7222

* 215' SW 1/4 NW-SE Sec 24, Twp 32 S, Rge 9. (location)
1815 Ft North from Southeast Corner of Section
2120 Ft West from Southeast Corner of Section
(Note: Locate well on Section Plat on reverse side)

CONTRACTOR: License # 5842
Name Gabbert-Jones, Inc.
City/State Wichita, KS

Nearest lease or unit boundary line 660' feet.
County Harper
Lease Name Attica Hospital Well# 4
Domestic well within 330 feet: yes no
Municipal well within one mile: yes no

Well Drilled For: Well Class: Type Equipment:
 Oil Swd Infield Mud Rotary
 Gas Inj Pool Ext. Air Rotary
 OWWO Expl Wildcat Cable

Depth to Bottom of fresh water 200 feet
Lowest usable water formation Salt Plain
Depth to Bottom of usable water 200 feet
Surface pipe by Alternate: 1 2
Surface pipe to be set 250 feet
Conductor pipe if any required None feet
Ground surface elevation N/A feet MSL
This Authorization Expires 10-29-85
Approved By 4-29-85

If OWWO: old well info as follows:

Operator
Well Name
Comp Date Old Total Depth
Projected Total Depth 3650 feet
Projected Formation at TD
Expected Producing Formations

I certify that we will comply with K.S.A. 55-101, et seq., plus eventually plugging hole to K.C.C. specifications.


Date 5/16/85 Signature of Operator or Agent

Approved By [Signature] Title Production Engineer
100' W NW SE 1980 FSL
2080 FEL

Must be filed with the K.C.C. five (5) days prior to commencing well
 This card void if drilling not started within six (6) months of date received by K.C.C.

Important procedures to follow: **RECEIVED**
 STATE CORPORATION COMMISSION

A Regular Section of Land
 1 Mile = 5,280 Ft.

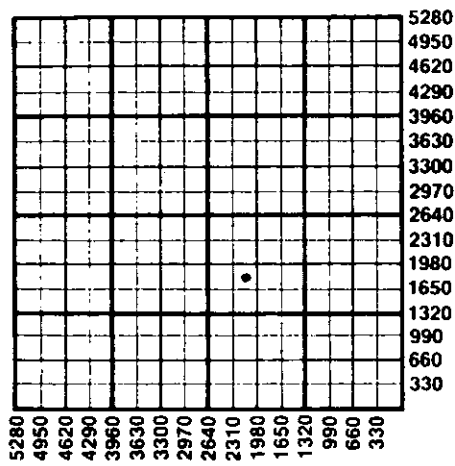

1. Notify District office before setting surface casing.
2. Set surface casing by circulating cement to the top.
3. File completion forms ACO-1 with K.C.C. within 90 days of well completion, following instructions on ACO-1, side 1, Wichita, Kansas and including copies of wireline logs.
4. Notify District office 48 hours prior to old well workover or re-entry.
5. Prior to plugging, prepare a plugging plan, then obtain agreement from the appropriate district office for an approved plugging plan.
6. Submit plugging report (CP-4) to K.C.C. after plugging is completed.
7. Obtain an approved injection docket number before disposing of salt water.
8. Notify K.C.C. within 10 days when injection commences or terminates.
9. If an alternate 2 completion, cement in the production pipe from below any usable water to surface within 120 days of spud date.

MAY 17 1985
 5-17-85
 CONSERVATION DIVISION

State Corporation Commission of Kansas
 Conservation Division
 200 Colorado Derby Building
 Wichita, Kansas 67202
 (316) 263-3238