

CARD MUST BE TYPED



State of Kansas

CARD MUST BE SIGNED

NOTICE OF INTENTION TO DRILL

(see rules on reverse side)

Starting Date 5 5 1987 month day year

API Number 15- 077-21,090-A-00-01

OPERATOR: License # 5039 Name Attica Gas Venture Corp. Inc. Address 123 N. Main City/State/Zip Attica, Kansas 67009 Contact Person Carl Durr Phone 316-254-7222

NW SE Sec. 24 Twp. 32S. S, Rg. 9W X West 1815 Ft. from South Line of Section 2120 Ft. from East Line of Section

(Note: Locate well on Section Plat on reverse side)

CONTRACTOR: License # 5429 Name Hays Well Service City/State Attica, Kansas 67009

Nearest lease or unit boundary line 660 feet County Harper

Lease Name Hospital Well # 4 SWd

Ground surface elevation 1461 feet MSL

Well Drilled For: Oil X SWD Gas Inj X OWWO Expl Wildcat Type Equipment: Infield X Mud Rotary Air Rotary Cable

Domestic well within 330 feet: yes X no

Municipal well within one mile: yes X no

Depth to bottom of fresh water 200

Depth to bottom of usable water 200

Surface pipe by Alternate: 1 X 2

Surface pipe planned to be set 257

Conductor pipe required None

Projected Total Depth 2950 feet

Formation Howard

If OWWO: old well info as follows:

Operator Attica Gas Venture Well Name Hospital #4 Comp Date 5/19/85 Old Total Depth 3550

I certify that well will comply with K.S.A. 55-101, et seq., plus eventually plugging hole to KCC specifications.

Date 3/14/87 Signature of Operator or Agent Carl [Signature] Title Engineer

For KCC Use:

Conductor Pipe Required feet; Minimum Surface Pipe Required 257 feet per Alt. 0 &


This Authorization Expires 10-15-87 Approved By 4-15-87 [Signature]

Must be filed with the K.C.C. five (5) days prior to commencing well
This card void if drilling not started within six (6) months of date received by K.C.C.

Important procedures to follow:

1. Notify District office before setting surface casing.
2. Set surface casing by circulating cement to the top.
3. File completion forms ACO-1 with K.C.C. within 90 days of well completion, following instructions on ACO-1, side 1, and including copies of wireline logs.
4. Notify District office 48 hours prior to old well workover or re-entry.
5. Prior to filing Intent, prepare a proposed plugging plan in case well is D & A, then obtain approval of plan when calling district office prior to setting surface pipe.
6. Submit plugging report (CP-4) to K.C.C. after plugging is completed.
7. Obtain an approved injection docket number before disposing of salt water.
8. Notify K.C.C. within 10 days when injection commences or terminates.
9. If an alternate 2 completion, cement in the production pipe from below any usable water to surface within 120 days of spud date.

A Regular Section of Land 1 Mile = 5,280 Ft.

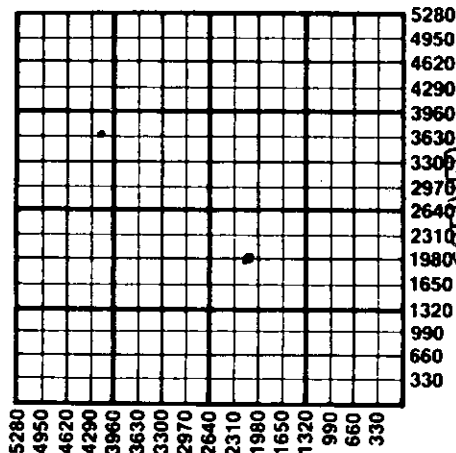

RECEIVED
STATE CORPORATION COMMISSION

4-15-87
APR 15 1987

CONSERVATION DIVISION
WICHITA, KANSAS

State Corporation Commission of Kansas
Conservation Division
200 Colorado Derby Building
Wichita, Kansas 67202
(316) 263-3238