

NOTICE OF INTENTION TO DRILL

(see rules on reverse side)

Starting Date July 14, 1987
 month day year

OPERATOR: License # 6151
 Name Kansas Crude
 Address 202 Wolcott Bldg.
 City/State/Zip Hutchinson, KS 67501
 Contact Person Tim Shaffer
 Phone 316-665-7201

CONTRACTOR: License # 5107
 Name H-30, Inc.
 City/State Wichita, KS 67202

Well Drilled For:	Well Class:	Type Equipment:
<input checked="" type="checkbox"/> Oil	<input checked="" type="checkbox"/> Infield	<input checked="" type="checkbox"/> Mud Rotary
<input type="checkbox"/> Gas	<input type="checkbox"/> Pool Ext.	<input type="checkbox"/> Air Rotary
<input type="checkbox"/> OWWO	<input type="checkbox"/> Wildcat	<input type="checkbox"/> Cable
<input type="checkbox"/> SWD		
<input type="checkbox"/> Inj		
<input type="checkbox"/> Expl		

If OWWO: old well info as follows:

Operator
 Well Name
 Comp Date Old Total Depth

I certify that well will comply with K.S.A. 55-101, et seq., plus eventually plugging hole to KCC specifications.

_____ cementing will be done immediately upon setting production casing.
 Date 7/13/87 Signature of Operator or Agent _____ Title Geologist/Agent

For KCC Use:

Conductor Pipe Required _____ feet; Minimum Surface Pipe Required 200 feet per Alt. 1
 This Authorization Expires 7-13-88 Approved By [Signature] 7-13-87

API Number 15-077-21,157-0000
 NW NW SE Sec. 4 Twp. 32 S, Rg. 9 X East
 2310 Ft. from South Line of Section
 2310 Ft. from East Line of Section

(Note: Locate well on Section Plat on reverse side)

Nearest lease or unit boundary line 2310 feet
 County Harper
 Lease Name Simpson Well # 2
 Ground surface elevation 1497 feet MSL
 Domestic well within 330 feet: ___ yes X no
 Municipal well within one mile: ___ yes X no
 Surface pipe by Alternate: 1 X 2
 Depth to bottom of fresh water 100
 Depth to bottom of usable water 200
 Surface pipe planned to be set 200'
 Projected Total Depth 4350 feet
 Formation Mississippi


VOC

Must be filed with the K.C.C. five (5) days prior to commencing well
This card void if drilling not started within six (6) months of date received by K.C.C.

Important procedures to follow:

1. Notify District office before setting surface casing.
2. Set surface casing by circulating cement to the top.
3. File completion forms ACO-1 with K.C.C. within 90 days of well completion, following instructions on ACO-1, side 1, and including copies of wireline logs.
4. Notify District office 48 hours prior to old well workover or re-entry.
5. Prior to filing Intent, prepare a proposed plugging plan in case well is D & A, then obtain approval of plan when calling district office prior to setting surface pipe.
6. Submit plugging report (CP-4) to K.C.C. after plugging is completed.
7. Obtain an approved injection docket number before disposing of salt water.
8. Notify K.C.C. within 10 days when injection commences or terminates.
9. If an alternate 2 completion, cement in the production pipe from below any usable water to surface within 120 days of spud date.

A Regular Section of Land 1 Mile = 5,280 Ft.

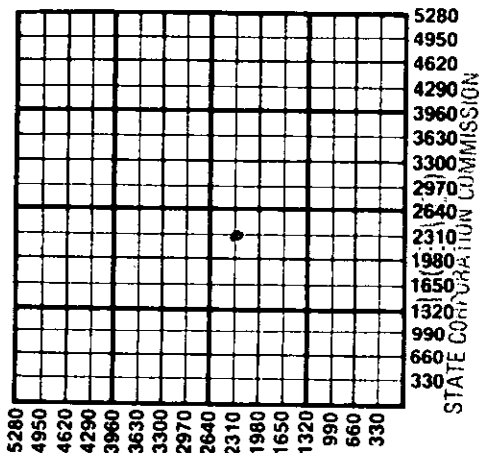

JUL 13 1987

7-13-87

CONSERVATION DIVISION
Wichita, Kansas

State Corporation Commission of Kansas
Conservation Division
200 Colorado Derby Building
Wichita, Kansas 67202
(316) 263-3238