

For KCC Use: 4-16-2001  
Effective Date: \_\_\_\_\_  
District # \_\_\_\_\_  
SGA?  Yes  No

KANSAS CORPORATION COMMISSION  
OIL & GAS CONSERVATION DIVISION

OWWO

Form C-1  
September 1999  
Form must be Typed  
Form must be Signed  
All blanks must be Filled

NOTICE OF INTENT TO DRILL

Must be approved by KCC five (5) days prior to commencing well

Expected Spud Date 3 / 10 / 01  
month day year

OPERATOR: License# KLN 5893  
Name: PRATT WELL SERVICE  
Address: P.O. Box 847  
City/State/Zip: Pratt, Ks 67124  
Contact Person: Ken Gates/Kevin Gates  
Phone: 316-672-2531

CONTRACTOR: License# KLN 5893  
Name: PRATT WELL SERVICE

Well Drilled For:	Well Class:	Type Equipment:
<input type="checkbox"/> Oil	<input type="checkbox"/> Enh Rec	<input checked="" type="checkbox"/> Infield
<input checked="" type="checkbox"/> Gas	<input type="checkbox"/> Storage	<input type="checkbox"/> Pool Ext.
<input checked="" type="checkbox"/> OWWO	<input type="checkbox"/> Disposal	<input type="checkbox"/> Wildcat
<input type="checkbox"/> Seismic; # of Holes	<input type="checkbox"/> Other	<input type="checkbox"/> Cable
<input type="checkbox"/> Other		

If OWWO: old well information as follows:  
Operator: Neo-Pet, Inc.  
Well Name: #1-N Alexander  
Original Completion Date: 3/6/93 Original Total Depth: 5110

Directional, Deviated or Horizontal wellbore?  Yes  No  
If Yes, true vertical depth: \_\_\_\_\_  
Bottom Hole Location: \_\_\_\_\_  
KCC DKT #: \_\_\_\_\_

Spot APPROX  
SE SE NE SW Sec. 11 Twp. 32 S. R. 15  West  
1490 feet from (S) N (circle one) Line of Section  
2790 feet from (E) W (circle one) Line of Section  
Is SECTION XXX Regular \_\_\_\_\_ Irregular?

(Note: Locate well on the Section Plat on reverse side)

County: Barber  
Lease Name: Alexander Well #: 1-N  
Field Name: Deer Head North

Is this a Prorated / Spaced Field?  Yes  No  
Target Information(s): Gas / Topeka Formation  
Nearest Lease or unit boundary: 1490 USD NORTH

Ground Surface Elevation: 2003 feet MSL  
Water well within one-quarter mile:  Yes  No  
Public water supply well within one mile:  Yes  No  
Depth to bottom of fresh water: 60 ft  
Depth to bottom of usable water: 180 ft  
Surface Pipe by Alternate: 1 2  
Length of Surface Pipe Planned to be set: 240 (already set)

Length of Conductor Pipe required: \_\_\_\_\_  
Projected Total Depth: 3750  
Producing Formation Target: Topeka

Water Source for Drilling Operations:  
Well \_\_\_\_\_ Farm Pond XX Other \_\_\_\_\_  
DWR Permit #: \_\_\_\_\_

(Note: Apply for Permit with DWR )

Will Cores be taken?  Yes  No  
If Yes, proposed zone: \_\_\_\_\_

AFFIDAVIT

RECEIVED  
KANSAS CORPORATION COMMISSION

The undersigned hereby affirms that the drilling, completion and eventual plugging of this well will comply with K.S.A. 55-101, et. seq.  
It is agreed that the following minimum requirements will be met:  
1. Notify the appropriate district office **prior** to spudding of well;  
2. A copy of the approved notice of intent to drill **shall be** posted on each drilling rig;  
3. The minimum amount of surface pipe as specified below **shall be set** by circulating cement to the top; in all cases surface pipe **shall be set** through all unconsolidated materials plus a minimum of 20 feet into the underlying formation.  
4. If the well is dry hole, an agreement between the operator and the district office on plug length and placement is necessary **prior to plugging**;  
5. The appropriate district office will be notified before well is either plugged or production casing is cemented in;  
6. If an ALTERNATE II COMPLETION, production pipe shall be cemented from below any usable water to surface within **120 days** of spud date. **In all cases, NOTIFY district office** prior to any cementing.

FEB 26 2001  
2-26-01

CONSERVATION DIVISION  
WICHITA, KS

I hereby certify that the statements made herein are true and to the best of my knowledge and belief.  
Date: Feb 26/01 Signature of Operator or Agent: Leigh Raymond Title: Agent

For KCC Use ONLY  
API # 15 - 007-22411-0001  
Conductor pipe required NONE feet  
Minimum surface pipe required 240 feet per Alt. (1)  
Approved by: JK 4-11-2001  
This authorization expires: 10-11-2001  
(This authorization void if drilling not started within 6 months of effective date.)  
Spud date: \_\_\_\_\_ Agent: \_\_\_\_\_

- Remember to:
- File Drill Pit Application (form CDP-1) with Intent to Drill;
  - File Completion Form ACO-1 within 120 days of spud date;
  - File acreage attribution plat according to field proration orders;
  - Notify appropriate district office 48 hours prior to workover or re-entry;
  - Submit plugging report (CP-4) after plugging is completed;
  - Obtain written approval before disposing or injecting salt water.

11  
22  
154

**IN ALL CASES PLOT THE INTENDED WELL ON THE PLAT BELOW**

*Plat of acreage attributable to a well in a prorated or spaced field*

*If the intended well is in a prorated or spaced field, please fully complete this side of the form. If the intended well is in a prorated or spaced field complete the plat below showing that the well will be properly located in relationship to other wells producing from the common source of supply. Please show all the wells and within 1 mile of the boundaries of the proposed acreage attribution unit for gas wells and within 1/2 mile of the boundaries of the proposed acreage attribution unit for oil wells.*

API No. 15 - 007-2241  
Operator: Pratt Well Service  
Lease: Alexander  
Well Number: 1-N  
Field: Deerhead North  
Number of Acres attributable to well: 160  
QTR / QTR / QTR of acreage: se of se - ne - nw



Location of Well: County: Barber  
1490 feet from S XX (circle one) Line of Section  
2790 feet from E / XX (circle one) Line of Section  
Sec. 11 Twp. 32 S. R. 15  East  West

Is Section XX Regular or \_\_\_\_\_ Irregular

If Section is Irregular, locate well from nearest corner boundary.  
Section corner used: \_\_\_ NE \_\_\_ NW \_\_\_ SE \_\_\_ SW

**PLAT**

*(Show location of the well and shade attributable acreage for prorated or spaced wells.)  
(Show footage to the nearest lease or unit boundary line.)*

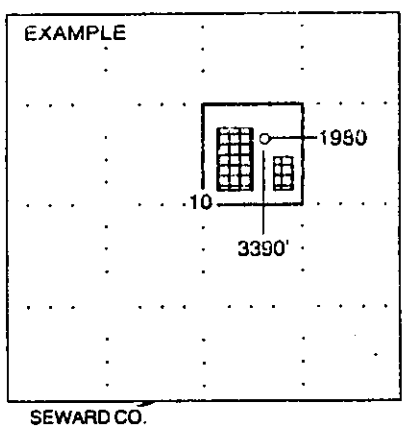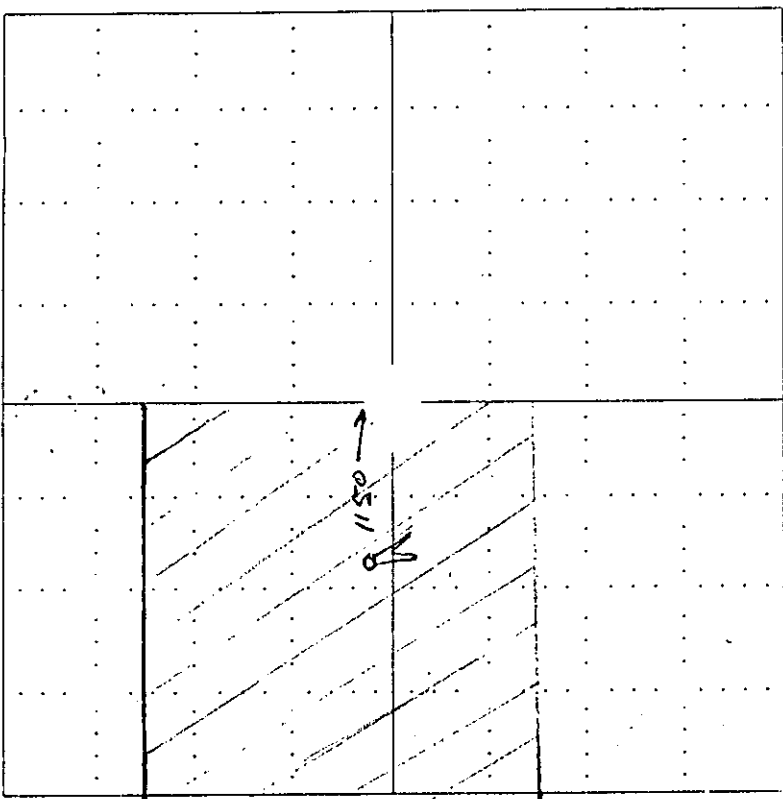

**NOTE: In all cases locate the spot of the proposed drilling location.**

**In plotting the proposed location of the well, you must show:**

1. The manner in which you are using the depicted plat by identifying section lines, i.e. 1 section, 1 section with 8 surrounding sections, 4 sections, etc.
2. The distance of the proposed drilling location from the section's south / north and east / west.
3. The distance to the nearest lease or unit boundary line.
4. If proposed location is located within a prorated or spaced field a certificate of acreage attribution plat must be attached: (CO-7 for oil wells; CG-8 for gas wells).