

FOR KCC USE:

FORM C-1 7/91

EFFECTIVE DATE: 4-11-94

FORM MUST BE TYPED

DISTRICT # 1

State of Kansas

FORM MUST BE SIGNED

SGAT Yes No

NOTICE OF INTENTION TO DRILL

ALL BLANKS MUST BE FILLED

Must be approved by the K.C.C. five (5) days prior to commencing well

Expected Spud Date March 31, 1994 month day year

Spot SW - NW - NE Sec 8 Twp 32 S Rg 9 East West

OPERATOR: License # 5429 Name: Bryce F. Hayes Oil & Gas Address: P.O. Box 108 City/State/Zip: Attica, KS 67009 Contact Person: Bryce F. Hayes Phone: (316) 254-7204 FAX (316)-254-7317

990 feet from South North line of Section 2310 feet from East West line of Section IS SECTION X REGULAR IRREGULAR?

CONTRACTOR: License # 5380 Name: Eagle Drilling, Inc. 265-1072

(NOTE: Locate well on the Section Plat on Reverse Side) County: Harper

Well Drilled For: Well Class: Type Equipment: X Oil Enh Rec Infield X Mud Rotary X Gas Storage X Pool Ext Air Rotary OWWO Disposal Wildcat Cable Seismic # of Holes Other

Lease Name: Kircher Well #: 4 Field Name: Sharon

If OWWO: old well information as follows: Operator: Well Name: Comp. Date: Old Total Depth

Is this a Prorated/Spaced Field? yes X no Target Formation(s): Mississippi Nearest lease or unit boundary: 330'

Directional, Deviated or Horizontal wellbore? yes X no If yes, true vertical depth: Bottom Hole Location

Ground Surface Elevation: 1500' feet MSL Water well within one-quarter mile: X yes no Public water supply well within one mile: yes X no

AFFIDAVIT

The undersigned hereby affirms that the drilling, completion and eventual plugging of this well will comply with K.S.A. 55-101, et. seq.

It is agreed that the following minimum requirements will be met:

- 1. Notify the appropriate district office prior to spudding of well; 2. A copy of the approved notice of intent to drill shall be posted on each drilling rig; 3. The minimum amount of surface pipe as specified below shall be set by circulating cement to the top; in all cases surface pipe shall be set through all unconsolidated materials plus a minimum of 20 feet into the underlying formation; 4. If the well is dry hole, an agreement between the operator and the district office on plug length and placement is necessary prior to plugging; 5. The appropriate district office will be notified before well is either plugged or production casing is cemented in; 6. IF AN ALTERNATE II COMPLETION, PRODUCTION PIPE SHALL BE CEMENTED FROM BELOW ANY USABLE WATER TO SURFACE WITHIN 120 DAYS OF SPUD DATE. IN ALL CASES, NOTIFY DISTRICT OFFICE PRIOR TO ANY CEMENTING.

I hereby certify that the statements made herein are true and to the best of my knowledge and belief.

Date: 3/29/94 Signature of Operator or Agent: [Signature] Title: Agent

RECEIVED KANSAS CORPORATION COMMISSION

MAR 29 1994 P.M.

3-29-94 CONSERVATION DIVISION WICHITA, KS

FOR KCC USE: API # 15- 077-21280-0000 Conductor pipe required NONE feet Minimum surface pipe required 200' feet per Alt. (1) X Approved by: CB 4-6-94 This authorization expires: 10-6-94 (This authorization void if drilling not started within 6 months of effective date.) Spud date: Agent:

REMEMBER TO:

- File Drill Pit Application (form CDP-1) with Intent to Drill; - File Completion Form ACO-1 within 120 days of spud date; - File acreage attribution plat according to field proration orders; - Notify appropriate district office 48 hours prior to workover or re-entry; - Submit plugging report (CP-4) after plugging is completed; - Obtain written approval before disposing or injecting salt water.

Mail to: Conservation Division, 200 Colorado Derby Building, 202 W. First St., Wichita, Kansas 67202-1286.

8 32 9

IN ALL CASES PLOT THE INTENDED WELL ON THE PLAT BELOW

PLAT OF ACREAGE ATTRIBUTABLE TO A WELL IN A PRORATED OR SPACED FIELD

If the intended well is in a prorated or spaced field, please fully complete this side of the form. If the intended well is in a prorated or spaced field complete the plat below showing that the well will be properly located in relationship to other wells producing from the common source of supply. Please show all the wells within 1 mile of the boundaries of the proposed acreage attribution unit for gas wells and within 1/2 mile of the boundaries of the proposed acreage attribution unit for oil wells.

API NO. 15- _____
 OPERATOR Bryce F. Hayes Oil & Gas
 LEASE Kircher 76
 WELL NUMBER 4
 FIELD Sharon

LOCATION OF WELL: COUNTY Harper
990 feet from ~~south~~ north line of section
2310 feet from ~~east~~ west line of section
 SECTION 8 TWP 32 RG 9



NUMBER OF ACRES ATTRIBUTABLE TO WELL 40
 QTR/QTR/QTR OF ACREAGE SW - NW - NE

IS SECTION X REGULAR or IRREGULAR
IF SECTION IS IRREGULAR, LOCATE WELL FROM NEAREST CORNER BOUNDARY.

Section corner used: NE NW SE SW

PLAT

(Show location of the well and shade attributable acreage for prorated or spaced wells.)
 (Show footage to the nearest lease or unit boundary line.)

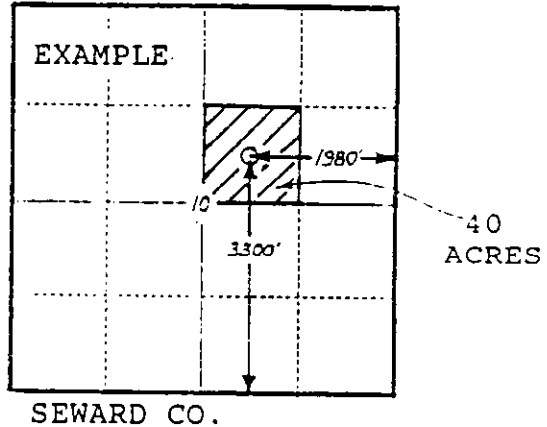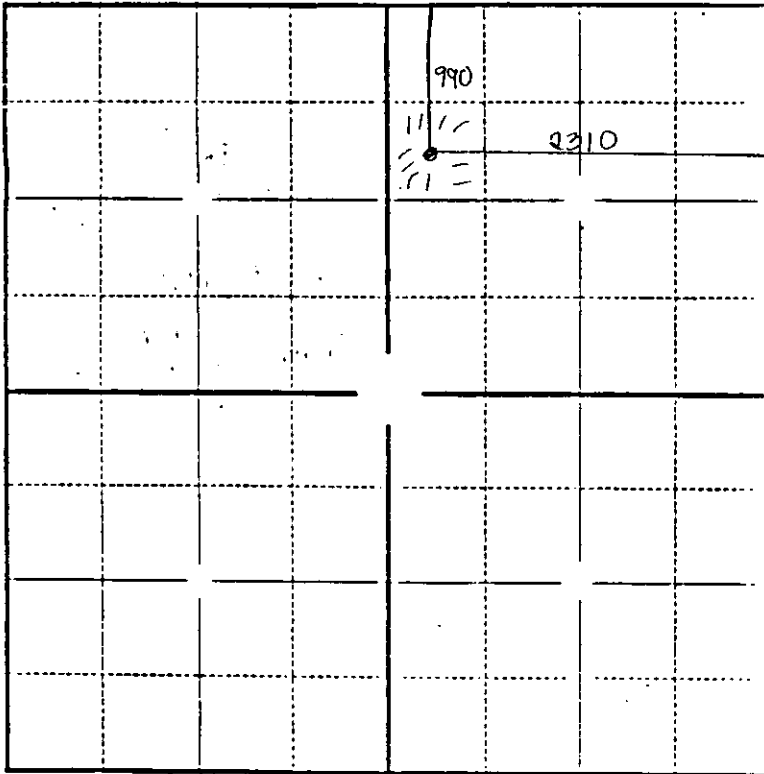

In plotting the proposed location of the well, you must show:

- 1) The manner in which you are using the depicted plat by identifying section lines, i.e. 1 section, 1 section with 8 surrounding sections, 4 sections, etc.;
- 2) the distance of the proposed drilling location from the section's south/north and east/west lines; and
- 3) the distance to the nearest lease or unit boundary line.