

FOR KCC USE:

EFFECTIVE DATE: 7-5-93

DISTRICT # 2

SGAT Yes No

State of Kansas
NOTICE OF INTENTION TO DRILL

Must be approved by the K.C.C. five (5) days prior to commencing well

FORM C-1 7/91
FORM MUST BE TYPED
FORM MUST BE SIGNED
ALL BLANKS MUST BE FILLED

Expected Spud Date ... August 2, 1993 ... 100' NE of SW SE 23 33 6 East West

OPERATOR: License # 8061
Name: Oil Producers, Inc. of Kansas
Address: P.O. Box 8647
City/State/Zip: Wichita, Ks 67208
Contact Person: John S. Weir
Phone: 136 681-0231

CONTRACTOR: License # 5822
Name: Val Energy Inc.

Well Drilled For: Well Class: Type Equipment:
X Oil ... Enh Rec X Infield X Mud Rotary
X Gas ... Storage ... Pool Ext. ... Air Rotary
X OWWO ... Disposal ... Wildcat ... Cable
... Seismic; ... # of Holes ... Other
... Other

If OWWO: old well information as follows:
Operator: Pickrell Drilling Co.
Well Name: Dierksen A #1
Comp. Date: 10/17/84 ... Old Total Depth 4450

Directional, Deviated or Horizontal wellbore? ... yes ... no
If yes, true vertical depth:
Bottom Hole Location:

731 feet from South / North line of Section
1909 feet from East / West line of Section
IS SECTION REGULAR IRREGULAR
(NOTE: Locate well on the Section Plat on Reverse Side)
County: Harper
Lease Name: Carothers Well #: A #1 OWWO
Field Name: Stohrville
Is this a Prorated/Spaced Field? ... yes ... no
Target Formation(s): Mississippi
Nearest lease or unit boundary: 330
Ground Surface Elevation: N/A feet MST
Water well within one-quarter mile: ... yes ... no
Public water supply well within one mile: ... yes ... no
Depth to bottom of fresh water: 140'
Depth to bottom of usable water: 180'
Surface Pipe by Alternate: X 1 2
Length of Surface Pipe Planned to be set: 218 (already set)
Length of Conductor pipe required: none set
Projected Total Depth: 5200
Formation at Total Depth:
Water Source for Drilling Operations:
... well ... farm pond X ... other
DWR Permit #: ...
Will Cores Be Taken?: ... yes ... no
If yes, proposed zone:

AFFIDAVIT

The undersigned hereby affirms that the drilling, completion and eventual plugging of this well will comply with K.S.A. 55-101, et. seq.
It is agreed that the following minimum requirements will be met:

- 1. Notify the appropriate district office prior to spudding of well;
- 2. A copy of the approved notice of intent to drill shall be posted on each drilling rig;
- 3. The minimum amount of surface pipe as specified below shall be set by circulating cement to the top; in all cases surface pipe shall be set through all unconsolidated materials plus a minimum of 20 feet into the underlying formation;
- 4. If the well is dry hole, an agreement between the operator and the district office on plug length and placement is necessary prior to plugging;
- 5. The appropriate district office will be notified before well is either plugged or production casing is cemented in;
- 6. IF AN ALTERNATE II COMPLETION, PRODUCTION PIPE SHALL BE CEMENTED FROM BELOW ANY USABLE WATER TO SURFACE WITHIN 120 DAYS OF SPUD DATE. IN ALL CASES, NOTIFY DISTRICT OFFICE PRIOR TO ANY CEMENTING.

I hereby certify that the statements made herein are true and to the best of my knowledge and belief.
Date: Signature of Operator or Agent: John S. Weir Title: President

FOR KCC USE:
API # 15- 077-21039-00-01
Conductor pipe required None feet
Minimum surface pipe required 218' feet per Alt.
Approved by: C.B. 6-30-93
This authorization expires: 12-30-93
(This authorization void if drilling not started within 6 months of effective date.)
Spud date: Agent:

REMEMBER TO:

- File Drill Pit Application (form CDP-1) with Intent to Drill;
- File Completion Form ACD-1 within 120 days of spud date;
- File acreage attribution plat according to field proration orders;
- Notify appropriate district office 48 hours prior to workover or re-entry;
- Submit plugging report (CP-4) after plugging is completed;
- Obtain written approval before disposing or injecting salt water.

Mail to: Conservation Division, 200 Colorado Derby Building, 202 W. First St., Wichita, Kansas 67202-1286.

RECEIVED
STATE CORPORATION COMMISSION
JUN 30 1993
CONSERVATION DIVISION
Wichita, Kansas

23
3
63

IN ALL CASES PLOT THE INTENDED WELL ON THE PLAT BELOW

PLAT OF ACREAGE ATTRIBUTABLE TO A WELL IN A PRORATED OR SPACED FIELD

If the intended well is in a prorated or spaced field, please fully complete this side of the form. If the intended well is in a prorated or spaced field complete the plat below showing that the well will be properly located in relationship to other wells producing from the common source of supply. Please show all the wells within 1 mile of the boundaries of the proposed acreage attribution unit for gas wells and within 1/2 mile of the boundaries of the proposed acreage attribution unit for oil wells.

API NO. 15- _____
 OPERATOR Oil Producers, Inc. of Kansas
 LEASE Carothers A #1 OWWO
 WELL NUMBER _____
 FIELD _____

LOCATION OF WELL: COUNTY Harper
 _____ feet from south/north line of section
760
 _____ feet from east/west line of section
1880
 SECTION 23 TWP 33 RG 6 W



NUMBER OF ACRES ATTRIBUTABLE TO WELL _____
 QTR/QTR/QTR OF ACREAGE _____

IS SECTION _____ REGULAR or _____ IRREGULAR
 IF SECTION IS IRREGULAR, LOCATE WELL FROM NEAREST
CORNER BOUNDARY.

Section corner used: _____ NE _____ NW _____ SE _____ SW

PLAT

(Show location of the well and shade attributable acreage for prorated or spaced wells.)
 (Show footage to the nearest lease or unit boundary line.)

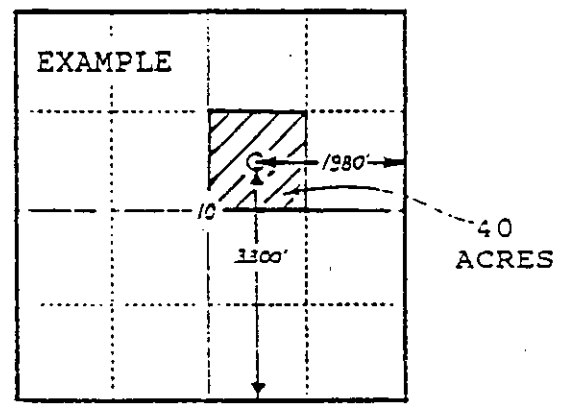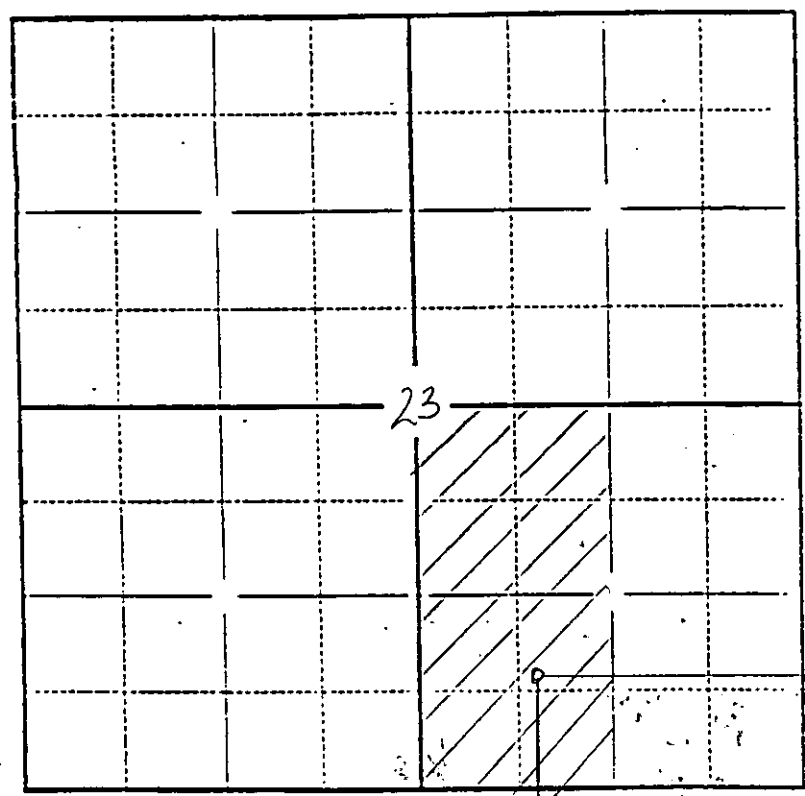

SEWARD CO.

1909' Approx
220 ACRES Less Railroad ROW

Approx 731'

In plotting the proposed location of the well, you must show:

- 1) The manner in which you are using the depicted plat by identifying section lines, i.e. 1 section, 1 section with 8 surrounding sections, 4 sections, etc.;
- 2) the distance of the proposed drilling location from the section's south/north and east/west lines; and
- 3) the distance to the nearest lease or unit boundary line.