

CARD MUST BE TYPED

State of Kansas
NOTICE OF INTENTION TO DRILL
(see rules on reverse side)

CARD MUST BE SIGNED

Starting Date: 10 9 84
month day year

API Number 15- 077-21,039-00-00

OPERATOR: License # 5123

100' NE/C SW SE Sec 23 Twp 33 S, Rge 6
(location) East West

Name Pickrell Drilling Company
Address 110 N. Market, Suite 205
City/State/Zip Wichita, Kansas 67202
Contact Person Larry Richardson
Phone (316) 262-8427

731 Ft North from Southeast Corner of Section
1909 Ft West from Southeast Corner of Section
(Note: Locate well on Section Plat on reverse side)

CONTRACTOR: License # 5123
Name Pickrell Drilling Company
City/State Wichita, Kansas

Nearest lease or unit boundary line 731 feet.
County Harper
Lease Name Dierksen 'A' Well# 1

Well Drilled For: Well Class: Type Equipment:
 Oil Swd Infield Mud Rotary
 Gas Inj Pool Ext. Air Rotary
 OWWO Expl Wildcat Cable

Domestic well within 330 feet: yes no
Municipal well within one mile: yes no

If OWWO: old well info as follows:

Operator
Well Name
Comp Date Old Total Depth
Projected Total Depth 4500 feet
Projected Formation at TD Mississippian
Expected Producing Formations Mississippian

Depth to Bottom of fresh water feet
Lowest usable water formation Harper Siltstone
Depth to Bottom of usable water 200 feet
Surface pipe by Alternate: 1 2
Surface pipe to be set 200+ feet
Conductor pipe if any required N/A feet
Ground surface elevation feet MSL
This Authorization Expires 4-2-85
Approved By 10-2-84
.....

I certify that we will comply with K.S.A. 55-101, et seq., plus eventually plugging hole to K.C.C. specifications.

Date 10-1-84 Signature of Operator or Agent

Larry Richardson
Title Geologist

MHC/KOHE 10/1/84 Form C-1 4/84

Must be filed with the K.C.C. five (5) days prior to commencing well
This card void if drilling not started within six (6) months of date received by K.C.C.

RECEIVED


CONSERVATION COMMISSION

OCT 2 1984

A Regular Section of Land

CONSERVATION MINES 5,280 Ft.

Wichita, Kansas

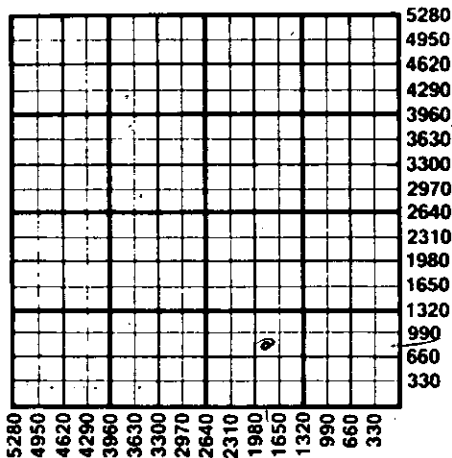

Important procedures to follow :

1. Notify District office before setting surface casing.
2. Set surface casing by circulating cement to the top.
3. File completion forms ACO-1 with K.C.C. within 90 days of well completion, following instructions on ACO-1, side 1, and including copies of wireline logs.
4. Notify District office 48 hours prior to old well workover or re-entry.
5. Prior to plugging, prepare a plugging plan, then obtain agreement from the appropriate district office for an approved plugging plan.
6. Submit plugging report (CP-4) to K.C.C. after plugging is completed.
7. Obtain an approved injection docket number before disposing of salt water.
8. Notify K.C.C. within 10 days when injection commences or terminates.
9. If an alternate 2 completion, cement in the production pipe from below any usable water to surface within 120 days of spud date.

State Corporation Commission of Kansas
Conservation Division
200 Colorado Derby Building
Wichita, Kansas 67202
(316) 263-3238