

OWWO

FOR KCC USE:

FORM C-1 7/91
FORM MUST BE TYPED
FORM MUST BE SIGNED
ALL BLANKS MUST BE FILLED

EFFECTIVE DATE: 5-19-99
DISTRICT # 2
SGA.....Yes.....No X

State of Kansas
NOTICE OF INTENTION TO DRILL

Must be approved by the K.C.C. five (5) days prior to commencing well

Expected Spud Date.....05.....22.....99.....
Month day year

Spot ✓ >C...SE..-SE. Sec ...22...Twp 33..S, Rg ..6..W East
West
.....660.....feet from South/North Line of Section

OPERATOR: LICENSE #.....8061.....
Name:.....OIL PRODUCERS, INC. OF KANSAS.....
Address:.....P.O. BOX 8647.....
City/State/Zip:.....WICHITA, KANSAS 67208.....
Contact Person:.....JOHN S. WEIR/DIANA RICHECKY.....
Phone:.....316-681-0231.....

.....660.....feet from East West Line of Section
IS SECTION X REGULAR..... IRREGULAR?

(Note: Locate well on the Section Plat on Reverse Side)

County:.....HARPER.....

Lease Name: ALLTON B.... Well #: 1 OWWO.....

Field Name: STONRVILLE EXT.....

Is this a Prorated / Spaced Field? ...yes ...no

Target Formation (s):.....MISSISSIPPI.....

Nearest Lease or unit boundary:660.....

Ground Surface Elevation : est. 1311'....feet MSL

Water well within one - quarter mile:yes ✓ no

Public water supply well within one mile:yes ✓ no

Depth to bottom of fresh water:

Depth to bottom of usable water:

Surface Pipe by Alternate:X.....1.....2

Length of Surface Pipe ~~Planned to be set:~~ 265 278

Length of Conductor pipe required:0.....

Projected Total Depth :4600.....

Formation at Total Depth:Mississippi.....

Water Source for Drilling Operations:

.....WellFarm Pond.....X.....other ✓

Permit #:

Will Cores Be Taken ? :yes ✓ no

If yes, proposed zone:

CONTRACTOR: License #:.....4958.....
Name: MALLARD JV, INC.

Well Drilled For: Well Class: Type Equipment:
.....OilEnh Recx.....Infieldx.....Mud Rotary
.....GasStoragePool ExtensionAir Rotary
.....X.....OWWODisposalWildcatCable
.....Seismic:# of HolesOther
.....Other.....

If OWWO: old well information as follows:
Operator: Lee Pillips.....
Well Name : #1 Allton.....
Comp. Date: 6/2/77.....Old Total Depth... 4476....

Directional, Deviated or Horizontal wellbore?yes...x...no ✓
If yes, true vertical depth:

AFFIDAVIT

The undersigned hereby affirms that the drilling, completion and eventual plugging of this well will comply with K.S.A. 55-101, et. seq. .
It is agreed that the following minimum requirements will be met. :

1. Notify the appropriate district office prior to spudding of well;
2. A copy of the approved notice of intent to drill shall be posted on each drilling rig;
3. The minimum amount of surface pipe as specified below shall be set by circulating cement to the top; in all cases surface pipe shall be set through all unconsolidated materials plus a minimum of 20 feet into the underlying formation;
4. If the well is dry hole, an agreement between the operator and the district office on plug length and placement is necessary prior to plugging;
5. The appropriate district office will be notified before well is either plugged or production casing is cemented in;
6. IF AN ALTERNATE II COMPLETION, PRODUCTION PIPE SHALL BE CEMENTED FROM BELOW ANY USABLE WATER TO SURFACE WITHIN 120 DAYS OF SPUD DATE. IN ALL CASES, NOTIFY DISTRICT OFFICE PRIOR TO ANY CEMENTING.

I hereby certify that the statements made herein are true and to the best of my knowledge and belief.

Date.....05/12/99.....Signature of Operator or Agent John S. Weir.....Title.....President.....

FOR KCC USE:
 API # 15- 077-204220001
 Conductor pipe required NONE feet
 Minimum surface pipe required 278 feet per Alt (1)
 Approved by: JK 5-14-99
 This authorization expires: 11-14-99
 (This authorization void if drilling not started within 6 months of effective date.)
 Spud date: _____ Agent: _____

RECEIVED
STATE CONSERVATION COMMISSION
MAY 14 1999
CONSERVATION DIVISION
Wichita, Kansas

22
33
6W

REMEMBER TO:

- File Drill Pit Application (form CDP - 1) with Intent to Drill;
- File Completion Form ACO -1 within 120 days of spud date;
- File acreage attribution plat according to field proration orders;
- Notify appropriate district office 48 hours prior to workover or re-entry;
- Submit plugging report (CP-4) after plugging is completed;
- Obtain written approval before disposing or injecting salt water.

Mail to: KCC - Conservation Division, 130 S. Market - Room 2078, Wichita, Kansas 67202.

IN ALL CASES PLOT THE INTENDED WELL ON THE PLAT BELOW

PLAT OF ACREAGE ATTRIBUTABLE TO A WELL IN A PRORATED OR SPACED FIELD

If the intended well is in a prorated or spaced field, please fully complete this side of the form. If the intended well is in a prorated or spaced field complete the plat below showing that the well will be properly located in relationship to other wells producing from the common source of supply. Please show all the wells within 1 mile of the boundaries of the proposed acreage attribution unit for gas wells and within 1/2 mile of the boundaries of the proposed acreage attribution unit for oil wells.

API NO. 15- _____
 OPERATOR OIL PRODUCERS, INC. OF KANSAS
 LEASE ALLTON B
 WELL NUMBER #1 OWWO
 FIELD _____

LOCATION OF WELL: COUNTY HARPER
 _____ feet from south/north line of section
 _____ feet from east/west line of section
 SECTION 22 TWP 33 S _____ RG 6 W


NUMBER OF ACRES ATTRIBUTABLE TO WELL 40
 QTR/QTR/QTR OF ACREAGE _____

IS SECTION X REGULAR or _____ IRREGULAR
 IF SECTION IS IRREGULAR, LOCATE WELL FROM NEAREST
 CORNER BOUNDARY.


Section corner used: _____

PLAT

(Show location of the well and shade attributable acreage for prorated or spaced wells.)
 (Show footage to the nearest lease or unit boundary line.)

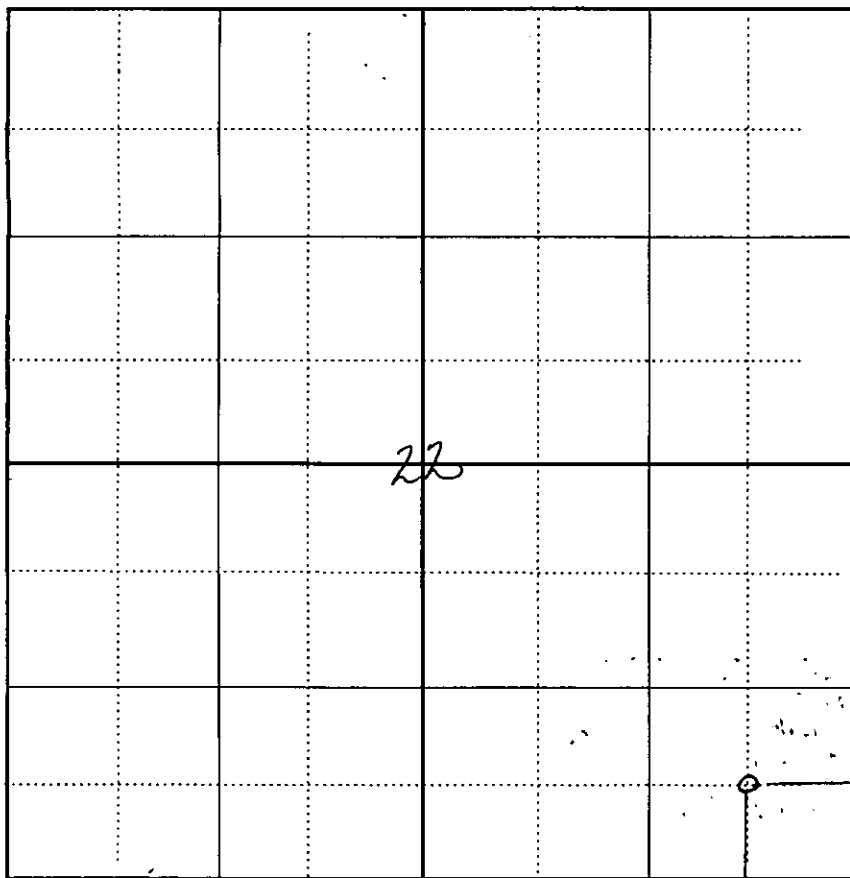

SECTION 22 HARPER COUNTY, KANSAS 660'

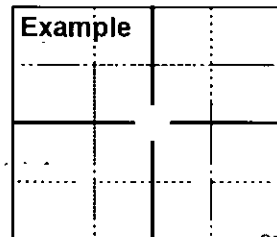

SEWARD CO.

RECEIVED
 STATE CORPORATION COMMISSION

MAY 14 1999

CONSERVATION DIVISION
 Wichita, Kansas

In plotting the proposed location of the well, you must show:

- 1) The manner in which you are using the depicted plat by identifying section lines, i.e. 1 section, 1 section with 8 surrounding sections, 4 sections, etc.;
- 2) the distance of the proposed drilling location from the section's south/north and east/west; and
- 3) the distance to the nearest lease or unit boundary line.