

FOR KCC USE:

CORRECTED INTENT AS TO LOCATION

FORM C-1 7/91

FORM MUST BE TYPED

FORM MUST BE SIGNED

ALL BLANKS MUST BE FILLED

EFFECTIVE DATE: 6-8-98

DISTRICT # 17
SGA Yes No X

NOTICE OF INTENTION TO DRILL

Must be approved by the K.C.C. five (5) days prior to commencing well

RECEIVED
KANSAS CORP COMM
1998 JUL 13 11:33

07-13-98

Expected Spud Date: 6/08/98
Month day year

Spot Approximately East
* C SW - NW Sec 15 Twp 33 S Rg 6 W West

* 3300 feet from South North Line of Section

* 4600 feet from East West Line of Section

OPERATOR: LICENSE # 8061
Name: OIL PRODUCERS, INC. OF KANSAS
Address: P.O. BOX 8647
City/State/Zip: WICHITA, KANSAS 67208
Contact Person: JOHN S. WEIR/DIANA RICHECKY
Phone: 316-681-0231

IS SECTION X REGULAR IRRREGULAR?
(Note: Locate well on the Section Plat on Reverse Side)
County: HARPER
Lease Name: ANTRIM TRUST Well #: 1
Field Name: STOHRVILLE

CONTRACTOR: License # 5929
Name: DUKE DRILLING CO., INC.

Is this a Prorated / Spaced Field? yes no
Target Formation (s): MISSISSIPPI
Nearest Lease or unit boundary: 660 WAS: 330

Well Drilled For: Well Class: Type Equipment:
X Oil Enh Rec x Infield x Mud Rotary
X Gas Storage Pool Extension Air Rotary
OWWO Disposal Wildcat Cable
Seismic: # of Holes Other

Ground Surface Elevation: feet MSL
Water well within one - quarter mile: yes no
Public water supply well within one mile: yes no

If OWWO: old well information as follows:
Operator:
Well Name:
Comp. Date: Old Total Depth

Depth to bottom of fresh water: 65
Depth to bottom of usable water: 180
Surface Pipe by Alternate: X 1 2

Directional, Deviated or Horizontal wellbore? yes x no
If yes, true vertical depth:
Bottom Hole Location:

Length of Surface Pipe Planned to be set: 265
Length of Conductor pipe required: 0
Projected Total Depth: 4600
Formation at Total Depth: Mississippi
Water Source for Drilling Operations: Well Farm Pond x other

DWR Permit #:
Will Cores Be Taken?: yes no
If yes, proposed zone:

AFFIDAVIT

* SPOT WAS: SE SW NW
SPOT IS: APPROX. C SW NW
* WAS: 8770' FSL 4290' FEL
IS: 3300' FSL 4600' FEL

The undersigned hereby affirms that the drilling, completion and eventual plugging of this well will comply with K.S.A. 55-101, et. seq.
It is agreed that the following minimum requirements will be met:

- 1. Notify the appropriate district office prior to spudding of well;
- 2. A copy of the approved notice of intent to drill shall be posted on each drilling rig;
- 3. The minimum amount of surface pipe as specified below shall be set by circulating cement to the top; in all cases surface pipe shall be set through all unconsolidated materials plus a minimum of 20 feet into the underlying formation;
- 4. If the well is dry hole, an agreement between the operator and the district office on plug length and placement is necessary prior to plugging;
- 5. The appropriate district office will be notified before well is either plugged or production casing is cemented in;
- 6. IF AN ALTERNATE II COMPLETION, PRODUCTION PIPE SHALL BE CEMENTED FROM BELOW ANY USABLE WATER TO SURFACE WITHIN 120 DAYS OF SPUD DATE. IN ALL CASES, NOTIFY DISTRICT OFFICE PRIOR TO ANY CEMENTING.

I hereby certify that the statements made herein are true and to the best of my knowledge and belief.

Date: 7/10/98 Signature of Operator or Agent: [Signature] Title: President

FOR KCC USE:
API # 15- 077-21354 0000
Conductor pipe required NONE feet
Minimum surface pipe required 200 feet per Alt. 1 X
Approved by: (jk) 6/3/98 /COR 7-15-98 JK
This authorization expires: 12.3 98
(This authorization void if drilling not started within 6 months of effective date.)
Spud date: Agent:

REMEMBER TO:

- File Drill Pit Application (form CDP - 1) with Intent to Drill;
- File Completion Form ACO -1 within 120 days of spud date;
- File acreage attribution plat according to field proration orders;
- Notify appropriate district office 48 hours prior to workover or re-entry;
- Submit plugging report (CP-4) after plugging is completed;
- Obtain written approval before disposing or injecting salt water.

Mail to: KCC - Conservation Division, 130 S. Market - Room 2078, Wichita, Kansas 67202.

15
33
6W

IN ALL CASES PLOT THE INTENDED WELL ON THE PLAT BELOW

PLAT OF ACREAGE ATTRIBUTABLE TO A WELL IN A PRORATED OR SPACED FIELD

If the intended well is in a prorated or spaced field, please fully complete this side of the form. If the intended well is in a prorated or spaced field complete the plat below showing that the well will be properly located in relationship to other wells producing from the common source of supply. Please show all the wells within 1 mile of the boundaries of the proposed acreage attribution unit for gas wells and within 1/2 mile of the boundaries of the proposed acreage attribution unit for oil wells.

API NO. 15- _____
 OPERATOR OIL PRODUCERS, INC. OF KANSAS
 LEASE ANTRIM TRUST
 WELL NUMBER #1
 FIELD _____

LOCATION OF WELL: COUNTY HARPER
3300 feet from south/north line of section
4200 feet from east/west line of section
 SECTION 15 TWP 33 S RG 6 W


NUMBER OF ACRES ATTRIBUTABLE TO WELL 10
 QTR/QTR/QTR OF ACREAGE _____

IS SECTION X REGULAR or _____ IRREGULAR
IF SECTION IS IRREGULAR, LOCATE WELL FROM NEAREST CORNER BOUNDARY.

Section corner used: _____

PLAT


(Show location of the well and shade attributable acreage for prorated or spaced wells.)
 (Show footage to the nearest lease or unit boundary line.)

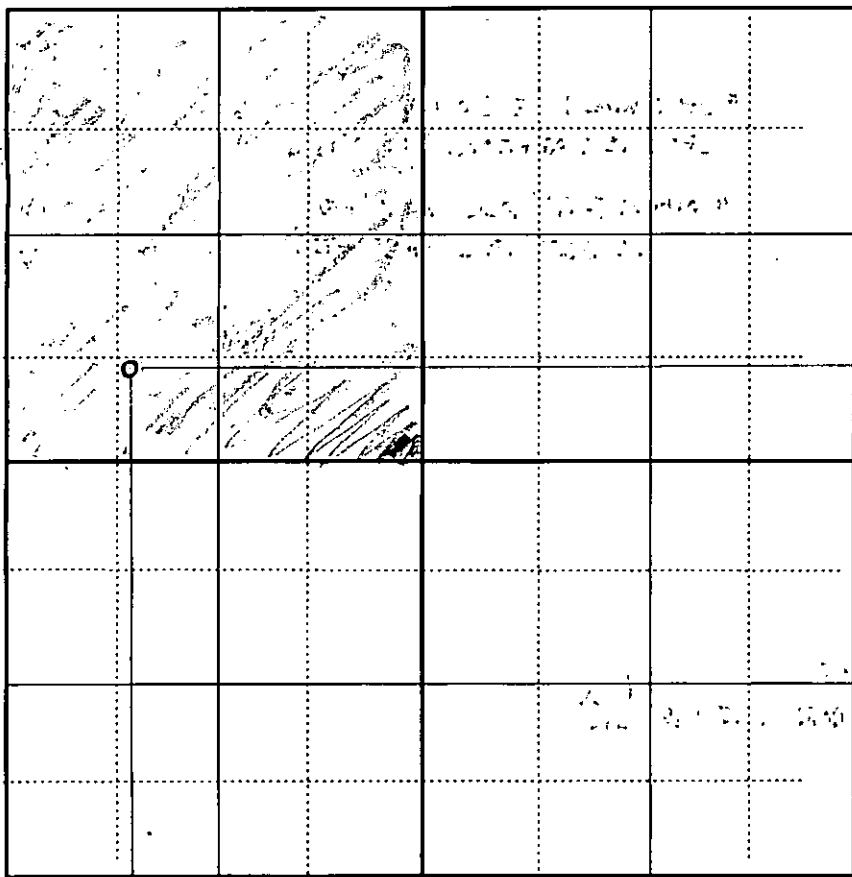

4200'

3300'

SECTION 15 HARPER COUNTY, KANSAS

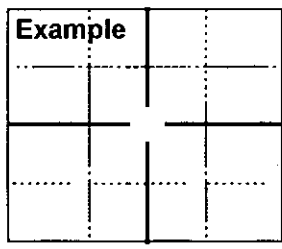

SEWARD CO.

RECEIVED
 KANSAS CORP COM
 1998 JUL 13 P 1:33

In plotting the proposed location of the well, you must show:

- 1) The manner in which you are using the depicted plat by identifying section lines, i.e. 1 section, 1 section with 8 surrounding sections, 4 sections, etc.;
- 2) the distance of the proposed drilling location from the section's south/north and east/west; and
- 3) the distance to the nearest lease or unit boundary line.

USE:
 EFFECTIVE DATE: 6-8-98
 DISTRICT # 7
 SGA Yes No No

State of Kansas
 NOTICE OF INTENTION TO DRILL
 Must be approved by the K.C.C. five (5) days prior to commencing well

Expected Spud Date 6 08 98
 Month day year

Spot
 SE SW - NW Sec. 15 Twp 33. S, Rg. 6. W
 East
 West
2970 feet from South North Line of Section

OPERATOR: LICENSE # 8061
 Name: OIL PRODUCERS, INC. OF KANSAS
 Address: P.O. BOX 8647
 City/State/Zip: WICHITA, KANSAS 67208
 Contact Person: JOHN S. WEIR/DIANA RICHECKY
 Phone: 316-681-0231

4290 feet from East West Line of Section
 IS SECTION REGULAR IRREGULAR?
 (Note: Locate well on the Section Plat on Reverse Side)

CONTRACTOR: License # 5929
 Name: DUKE DRILLING CO., INC.

County: HARPER
 Lease Name: ANTRIM TRUST Well #: 1
 Field Name: STOHRVILLE
 Is this a Prorated / Spaced Field? yes no

Well Drilled For:	Well Class:	Type Equipment:
<input checked="" type="checkbox"/> Oil	<input type="checkbox"/> Enh Rec	<input checked="" type="checkbox"/> Infield
<input checked="" type="checkbox"/> Gas	<input type="checkbox"/> Storage	<input type="checkbox"/> Mud Rotary
<input type="checkbox"/> OWWO	<input type="checkbox"/> Disposal	<input type="checkbox"/> Pool Extension
<input type="checkbox"/> Seismic:	<input type="checkbox"/> # of Holes	<input type="checkbox"/> Wildcat
<input type="checkbox"/> Other	<input type="checkbox"/> Other	<input type="checkbox"/> Air Rotary
		<input type="checkbox"/> Cable

Target Formation (s): MISSISSIPPI
 Nearest Lease or unit boundary: 330
 Ground Surface Elevation: est 1345 feet MSL

If OWWO: old well information as follows:
 Operator: _____
 Well Name: _____
 Comp. Date: _____ Old Total Depth _____

Water well within one - quarter mile: yes no
 Public water supply well within one mile: yes no
 Depth to bottom of fresh water: ~65
 Depth to bottom of usable water: 180
 Surface Pipe by Alternate: X 1 2

Directional, Deviated or Horizontal wellbore? yes no
 If yes, true vertical depth: _____
 Bottom Hole Location: _____

Length of Surface Pipe Planned to be set: 265
 Length of Conductor pipe required: 0
 Projected Total Depth: 4600
 Formation at Total Depth: Mississippi
 Water Source for Drilling Operations: _____

_____ Well _____ Farm Pond other
 DWR Permit #: _____
 Will Cores Be Taken?: yes no
 If yes, proposed zone: _____

AFFIDAVIT

The undersigned hereby affirms that the drilling, completion and eventual plugging of this well will comply with K.S.A. 55-101, et. seq.
 It is agreed that the following minimum requirements will be met:

1. Notify the appropriate district office prior to spudding of well;
2. A copy of the approved notice of intent to drill shall be posted on each drilling rig;
3. The minimum amount of surface pipe as specified below shall be set by circulating cement to the top; in all cases surface pipe shall be set through all unconsolidated materials plus a minimum of 20 feet into the underlying formation;
4. If the well is dry hole, an agreement between the operator and the district office on plug length and placement is necessary prior to plugging;
5. The appropriate district office will be notified before well is either plugged or production casing is cemented in;
6. IF AN ALTERNATE II COMPLETION, PRODUCTION PIPE SHALL BE CEMENTED FROM BELOW ANY USABLE WATER TO SURFACE WITHIN 120 DAYS OF SPUD DATE. IN ALL CASES, NOTIFY DISTRICT OFFICE PRIOR TO ANY CEMENTING.

I hereby certify that the statements made herein are true and to the best of my knowledge and belief.

Date: 6/02/98 Signature of Operator or Agent: John S. Weir Title: President

FOR KCC USE:	
API # 15-	<u>077-213540000</u>
Conductor pipe required	<u>NONE</u> feet
Minimum surface pipe required	<u>200</u> feet per Att <input checked="" type="checkbox"/> X
Approved by:	<u>JK 6-3-98</u>
This authorization expires: <u>12-3-98</u>	
(This authorization void if drilling not started within 6 months of effective date.)	
Spud date:	Agent: _____

REMEMBER TO:

- File Drill Pit Application (form CDP - 1) with Intent to Drill;
- File Completion Form ACO -1 within 120 days of spud date;
- File acreage attribution plat according to field proration orders;
- Notify appropriate district office 48 hours prior to workover or re-entry;
- Submit plugging report (CP-4) after plugging is completed;
- Obtain written approval before disposing or injecting salt water.

Mail to: KCC - Conservation Division, 130 S. Market - Room 2078, Wichita, Kansas 67202.

RECEIVED 15 33 645
 KANSAS CORP FORM
 1990 JUN -3 12:46