

NOTICE OF INTENTION TO DRILL

(see rules on reverse side)

Starting Date September 14 1988
month day year

API Number 15-007-22,205-0000

OPERATOR: License # ... 6167
Name Hesse Petroleum Co./ Hessco Inc.
Address ... 400 N Woodlawn, Ste 7
City/State/Zip ... Wichita, KS 67208
Contact Person ... Dave Hesse
Phone ... 316-685-474690' W-G-N/2-N/2 Sec. 14... Twp. 32. S, Rg. 15... East
West
4620' Ft. from South Line of Section
2730' Ft. from East Line of Section

(Note: Locate well on Section Plat on reverse side)

CONTRACTOR: License # ... 5929
Name ... Duke Drilling Company
City/State ... Wichita, KSNearest lease or unit boundary line 2550' feet
County ... BarberLease Name ... Alexander Well # ... 1
Ground surface elevation 2019' feet MSLWell Drilled For: Well Class: Type Equipment:
 Oil SWD Infield Mud Rotary
 Gas Inj Pool Ext. Air Rotary
 OWWO Expl Wildcat CableDomestic well within 330 feet: yes no
Municipal well within one mile: yes noDepth to bottom of fresh water 180'
Depth to bottom of usable water 200'

If OWWO: old well info as follows:

Operator
Well Name
Comp Date Old Total DepthSurface pipe by Alternate: 1 2
Surface pipe planned to be set 225'Conductor pipe required
Projected Total Depth 5100' feet
Formation ... Simpson

I certify that well will comply with K.S.A. 55-101, et seq., plus eventually plugging hole to KCC specifications.

Date ... 9-9-88 Signature of Operator or Agent *Dave Hesse* Title ... Partner

For KCC Use:


Conductor Pipe Required feet; Minimum Surface Pipe Required 225' feet per Alt. 1
This Authorization Expires ... 3-12-89 Approved By LKM 9-12-88EFFECTIVE DATE: 9-17-88

Must be filed with the K.C.C. five (5) days prior to commencing well
This card void if drilling not started within six (6) months of date received by K.C.C.

Important procedures to follow:

1. Notify District office before setting surface casing.
2. Set surface casing by circulating cement to the top.
3. File completion forms ACO-1 with K.C.C. within 90 days of well completion, following instructions on ACO-1, side 1, and including copies of wireline logs.
4. Notify District office 48 hours prior to old well workover or re-entry.
5. Prior to filing Intent, prepare a proposed plugging plan in case well is D & A, then obtain approval of plan when calling district office prior to setting surface pipe.
6. Submit plugging report (CP-4) to K.C.C. after plugging is completed.
7. Obtain an approved injection docket number before disposing of salt water.
8. Notify K.C.C. within 10 days when injection commences or terminates.
9. If an alternate 2 completion, cement in the production pipe from below any usable water to surface within 120 days of spud date.

A Regular Section of Land 1 Mile = 5,280 Ft.

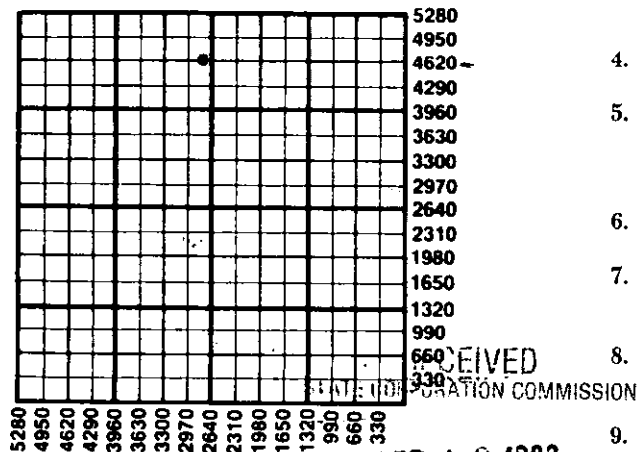

SEP 12 1988
9-12-88
CONSERVATION DIVISION
Wichita, Kansas

State Corporation Commission of Kansas
Conservation Division
200 Colorado Derby Building
Wichita, Kansas 67202
(316) 263-3238