


STATE OF KANSAS
STATE CORPORATION COMMISSION
CONSERVATION DIVISION
P. O. BOX 17027
WICHITA, KANSAS 67217

WELL PLUGGING RECORD

NORTH

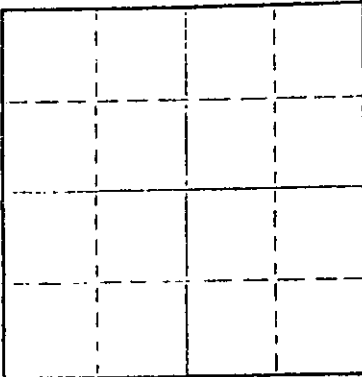

Locate well correctly on above
Section Plat

Barber County, Sec. 9 Twp. 32S Rge. (E) 15(W)
Location as "NE/CNW&SW" or footage from lines C NW NE
Lease Owner SANDS DRILLING COMPANY
Lease Name D. W. Skinner Trust Well No. 1
Office Address 912 Philtower Bldg., Tulsa, Okla. 74103
Character of Well (completed as Oil, Gas or Dry Hole) Dry Hole
Date well completed 1-1 19 76
Application for plugging filed 1-1 19 76
Application for plugging approved 1-1 19 76
Plugging commenced 1-1 19 76
Plugging completed 1-1 19 76
Reason for abandonment of well or producing formation No commercial quantities of oil or gas encountered.
If a producing well is abandoned, date of last production 19
Was permission obtained from the Conservation Division or its agents before plugging was commenced? Yes

Name of Conservation Agent who supervised plugging of this well G. R. Biberstein
Producing formation Depth to top Bottom Total Depth of Well 4971 Feet
Show depth and thickness of all water, oil and gas formations.

OIL, GAS OR WATER RECORDS

CASING RECORD

FORMATION	CONTENT	FROM	TO	SIZE	PUT IN	PULLED OUT
Surface Hole	Water	Surf.	215	8-5/8"	208	None

Describe in detail the manner in which the well was plugged, indicating where the mud fluid was placed and the method or methods used in introducing it into the hole. If cement or other plugs were used, state the character of same and depth placed, from feet to feet for each plug set.

Fluid to 250', plug, 50 sx cement;
Fluid to 40', plug, 15 sx cement;
Five sacks cement in rat hole.

(If additional description is necessary, use BACK of this sheet)

Name of Plugging Contractor D N B DRILLING, INC.
Address 701 First National Building
Wichita, Kansas 67202

STATE OF KANSAS, COUNTY OF ss.

JAMES L. DONELSON

(employee of owner) or (owner or operator) of the above-described well, being first duly sworn on oath, says: That I have knowledge of the facts, statements, and matters herein contained and the log of the above-described well as filed and that the same are true and correct. So help me God.

(Signature)

701 First Nat'l Bldg., Wichita, Kansas

(Address)

SUBSCRIBED AND SWORN TO before me this 9th day of January 19 76

Ella Priess

My commission expires 8-25-76

Ella Priess

Notary Public.

Ella Priess
STATE NOTARY PUBLIC
Sedgwick County, Kansas
My Com. Expires Aug. 25, 1976

RECEIVED
STATE CORPORATION COMMISSION

JAN 12 1976
1-12-76
CONSERVATION DIVISION
Wichita, Kansas

DRILLERS' LOG

SANDS DRILLING COMPANY
 No. 1 D. W. Skinner Trust
 C NW NE, Sec. 9-32S-15W
 Barber County, Kansas

Elev:

Commenced: 12-19-75
 Completed: 1- 1-76

Surface Casing: 208' of
 8-5/8" cemented w/200 sx
 common cement, 38 cc.
 12-19-75

FORMATIONDEPTH

Surface Hole	0 - 215
Shale	215 - 2254
Shale & Lime	2254 - 2415
Lime & Shale	2415 - 3140
Shale & Lime	3140 - 3350
Shale	3350 - 3570
Lime & Shale	3570 - 3980
Shale & Lime	3980 - 4185
Lime & Shale	4185 - 4519
Lime	4519 - 4799
Shale & Lime	4799 - 4853
Cherty Lime	4853 - 4940
Lime & Shale	4940 - 4971 RTD

I do hereby certify that the foregoing statements are true and correct to the best of my knowledge and belief.

D N B DRILLING, INC.

James L. Donelson
 JAMES L. DONELSON

STATE OF KANSAS: ss:

Subscribed and sworn to before me this 9th day of January, 1976.

Ella Priess
 Ella Priess, Notary Public

RECEIVED
 THE STATE OF KANSAS
 JAN 12 1976
 1-12-76

Ella Priess
 STATE NOTARY PUBLIC
 Sedgwick County, Kansas
 My Com. Expires Aug. 25, 1976