

15-007-19028-0000

STATE OF KANSAS
STATE CORPORATION COMMISSION

Give All Information Completely
Make Required Affidavit
Mail or Deliver Report to:
Conservation Division
State Corporation Commission
11 No. Broadway
Wichita, Kansas

WELL PLUGGING RECORD

Barber County, Sec. 9 Twp. 32S Rge. 15 (W)

Location as "NE/CNW/SW" or footage from lines C S/2 SW SE

Lease Owner Bowers Drilling Company, Inc.

Lease Name Marsh Well No. 1

Office Address 1434 Wichita Plaza, Wichita, Kansas

Character of Well (completed as Oil, Gas or Dry Hole) Dry Hole

Date well completed 6-5 19 64

Application for plugging filed 6-9 19 64

Application for plugging approved 6-5 19 64


Plugging commenced 6-5 19 64

Plugging completed 6-5 19 64

Reason for abandonment of well or producing formation Dry Hole

If a producing well is abandoned, date of last production 19

Was permission obtained from the Conservation Division or its agents before plugging was commenced? Yes, verbally

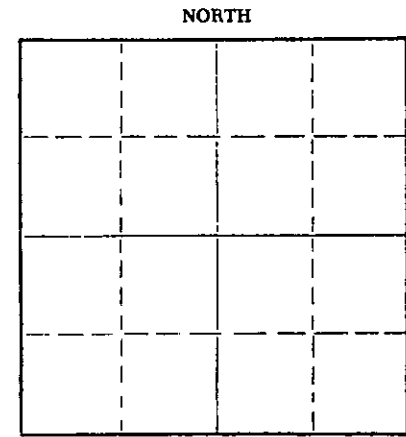

Locate well correctly on above Section Plat

Name of Conservation Agent who supervised plugging of this well

Producing formation Depth to top Bottom Total Depth of Well 4900 Feet

Show depth and thickness of all water, oil and gas formations.

OIL, GAS OR WATER RECORDS

CASING RECORD

FORMATION	CONTENT	FROM	TO	SIZE	PUT IN	PULLED OUT
				8-5/8"	249	

Describe in detail the manner in which the well was plugged, indicating where the mud fluid was placed and the method or methods used in introducing it into the hole. If cement or other plugs were used, state the character of same and depth placed, from feet to feet for each plug set.

Filled with heavy mud to 240'
Set first plug at 240' with 25 sax cement
Filled with heavy mud to 40'
Set second plug at 40' with 10 sax cement, 2 sax cement in rathole

RECEIVED
STATE CORPORATION COMMISSION

JUN 11 1964
6-11-64
CONSERVATION DIVISION
Wichita, Kansas

Name of Plugging Contractor Bowers Drilling Company, Inc.
Address 1434 Wichita Plaza, Wichita, Kansas

STATE OF KANSAS, COUNTY OF SEDGWICK, ss. Emil E. Bowers

(employee of owner) or (owner or operator) of the above-described well, being first duly sworn on oath, says: That I have knowledge of the facts, statements, and matters herein contained and the log of the above-described well as filed and that the same are true and correct. So help me God.

(Signature) Emil E. Bowers

1434 Wichita Plaza (Address)

SUBSCRIBED AND SWORN TO before me this 9th day of June, 19 64

Herman J. Miller Notary Public

My commission expires May 1, 1966

WELL LOG

COMPANY: Bowers Drilling Company, Inc.
 CONTRACTOR: Bowers Drilling Company, Inc.
 FARM: Marsh #1
 LOCATION: C S/2 SW SE Section 9-32S-15W
 Barber County, Kansas
 COMMENCED: May 22, 1964
 COMPLETED: June 5, 1964
 ELEVATION: 1956 Kelly Bushing

0 - 1005	Redbed
1005 - 1533	Redbed and shale
1533 - 1957	Shale and shells
1957 - 2475	Lime and shale
2475 - 2870	Lime
2870 - 3449	Lime and shale
3449 - 3567	Lime
3567 - 4127	Lime and shale
4127 - 4270	Sand and shale
4270 - 4794	Lime and shale
4794 - 4900	Chert
4900	T. D.

RECEIVED
 STATE CORPORATION COMMISSION

JUN 11 1964
 6-11-64
 CONSERVATION DIVISION
 Wichita, Kansas

LOG TOPS:

Heebner	4094	Lansing	4270
Douglas Shale	4127	Base/Kansas City	4695
Upper Douglas Sand Zone	4165	Mississippian	4794
Lower Douglas Sand	4236		

STATE OF KANSAS)
) SS
 COUNTY OF SEDGWICK)

I, Emil E. Bowers, do hereby certify that the above and foregoing is a true and correct copy of the copy of the log of the Marsh #1 located C S/2 SW SE Section 9-32S-15W, Barber County, Kansas, as reflected by the files of Bowers Drilling Company, Inc.

Emil E. Bowers

Subscribed and sworn to before me, a Notary Public in and for Sedgwick County, Kansas, this 9th day of June, 1964.

Donna F. Miller
 Donna F. Miller, Notary Public

My commission expires May 1, 1966.