


STATE OF KANSAS  
 STATE CORPORATION COMMISSION  
 CONSERVATION DIVISION  
 P. O. BOX 17027  
 WICHITA, KANSAS 67217

FORM CP-4

WELL PLUGGING RECORD

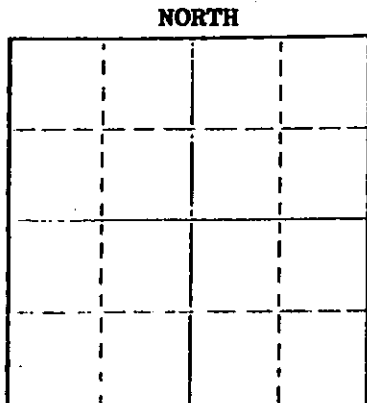

Locate well correctly on above Section Plat

Barber County, Sec. 8 Twp. 32S. Rge. (E) 15 (W)  
 Location as "NE/CNW/SW" or footage from lines SW/4 NE/4 SW/4  
 Lease Owner Atlantic Richfield  
 Lease Name W.L. Welsh Well No. B-#1  
 Office Address 1112 - 11th Street, Woodward, Oklahoma 73801  
 Character of Well (completed as Oil, Gas or Dry Hole)  
 Date well completed 19  
 Application for plugging filed 19  
 Application for plugging approved 19  
 Plugging commenced August 29, 1975  
 Plugging completed September 2, 1975  
 Reason for abandonment of well or producing formation  
 If a producing well is abandoned, date of last production 19  
 Was permission obtained from the Conservation Division or its agents before plugging was commenced? yes

Name of Conservation Agent who supervised plugging of this well G.R. Biberstein  
 Producing formation Depth to top Bottom Total Depth of Well 4925 Feet  
 Show depth and thickness of all water, oil and gas formations.

OIL, GAS OR WATER RECORDS

CASING RECORD

FORMATION	CONTENT	FROM	TO	SIZE	PUT IN	PULLED OUT
				4 1/2"	4924'	4049, 40'
				10 3/4"	309'	None

Describe in detail the manner in which the well was plugged, indicating where the mud fluid was placed and the method or methods used in introducing it into the hole. If cement or other plugs were used, state the character of same and depth placed, from feet to feet for each plug set.

shot @ 4046', spotted 50 sacks cement, displaced with mud, from 259' - 359', capped surface with 15 sacks cement 3' - 33', welded on steel plate.

RECEIVED  
 STATE CORPORATION COMMISSION

SEP 05 1975  
 9-5-75

(If additional description is necessary, use BACK of this sheet)  
 Name of Plugging Contractor Lillard Casing Pulling, Inc.  
 Address P.O. Box 962, Woodward, Oklahoma 73801

CONSERVATION DIVISION  
 Wichita, Kansas

STATE OF OKLAHOMA COUNTY OF WOODWARD, ss

Lowell L. Lillard (employee of owner) or (owner or operator) of the above-described well, being first duly sworn on oath, says: That I have knowledge of the facts, statements, and matters herein contained and the log of the above-described well as filed and that the same are true and correct. So help me God.

(Signature) *Lowell Lillard*  
 P.O. Box 962, Woodward, Oklahoma 73801

Subscribed and sworn to before me this 4th day of September, 1975

My commission expires May 19, 1979 *Juanita J. Camp* Notary Public

15-007-00013-0000

COMPANY SINCLAIR OIL & GAS COMPANY

SEC. 8 T. 32S R. 15W

FARM T. L. WELSH "B" NO. 1


LOC. SW, NE, SW

TOTAL DEPTH 4925'

COUNTY BARBER CO., KANSAS

COMM. April 22, 1960 COMP. May 11, 1960

CONTRACTOR GARVEY DRILLING COMPANY

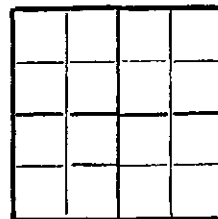

CASING 10 3/4" @ 309' w/350 sax.  
4 1/2" @ 4921' w/250 sax.

ELEVATION 1932' DF

PRODUCTION

FIGURES INDICATE BOTTOM OF FORMATIONS

30	Surface soil & red bed
240	Red bed, gyp, & shells
310	Red bed & gyp
1430	Shale & sand
1450	Anhydrite
1845	Shale & lime
1875	Shale & shells
2455	Lime & shale
2665	Lime
2765	Lime & shale
3050	Lime
3250	Shale & lime
3657	Lime & shale
4038	Lime
4067	Lime & shale
4338	Lime
4731	Lime & chert
4776	Lime
4810	Mississippi chert
4925	Mississippi limo.
4925	T. D.

RECEIVED  
STATE CORPORATION COMMISSION

AUG 19 1975  
8-19-75  
CONSERVATION DIVISION  
Wichita, Kansas

State of KANSAS  
County of BARTON } ss:

I, VERNE A. MORRIS of GARVEY DRILLING COMPANY

upon oath state that the above and foregoing is a true and correct copy of the log of the #1 WELSH "B" well.

Subscribed and sworn to before me this 20th day of May 19 60  
Verne A. Morris

My Commission Expires: April 14, 1963  
Arthur J. [Signature]  
NOTARY PUBLIC