


STATE OF KANSAS
STATE CORPORATION COMMISSION

Give All Information Completely
Make Required Affidavit
Mail or Deliver Report to:
Conservation Division
State Corporation Commission
212 North Market, Insurance Bldg.
Wichita, Kansas

WELL PLUGGING RECORD

NORTH

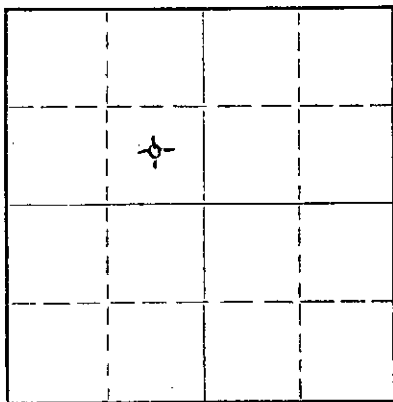

Locate well correctly on above
Section Plat

Barber County. Sec. 13 Twp. 32S Rge. 15W (E) (W)

Location as "NE/CNWSW" or footage from lines Cen. SE NW
Lease Owner Lario Oil & Gas Company
Lease Name Stumph Well No. 1
Office Address 301 South Market, Wichita 2, Kansas
Character of Well (completed as Oil, Gas or Dry Hole) Dry Hole
Date well completed March 23, 19 61
Application for plugging filed March 23, 19 61
Application for plugging approved March 23, 19 61
Plugging commenced March 23, 19 61
Plugging completed 10:30 P.M. March 23, 19 61
Reason for abandonment of well or producing formation _____

If a producing well is abandoned, date of last production _____ 19____
Was permission obtained from the Conservation Division or its agents before plugging was commenced? Yes

Name of Conservation Agent who supervised plugging of this well Fred Hampel
Producing formation _____ Depth to top _____ Bottom _____ Total Depth of Well 5048 Feet
Show depth and thickness of all water, oil and gas formations.

OIL, GAS OR WATER RECORDS

CASING RECORD

FORMATION	CONTENT	FROM	TO	SIZE	PUT IN	PULLED OUT
				8 5/8"	323'	Set @ 333' Cem. w/ 275 sacks

Describe in detail the manner in which the well was plugged, indicating where the mud fluid was placed and the method or methods used in introducing it into the hole. If cement or other plugs were used, state the character of same and depth placed, from _____ feet to _____ feet for each plug set.

Mud from total depth to 300'. Plug at 300' w/ 1/2 sack hulls, 15 sacks cement through drill pipe; mud to 35', plug at 35' w/ 1/2 sack hulls, 10 sacks cement to base cellar.

RECEIVED
STATE CORPORATION COMMISSION
MAR 30 1961
3-30-61
CONSERVATION DIVISION
Wichita, Kansas

(If additional description is necessary, use BACK of this sheet)
Name of Plugging Contractor Prime Drilling Co.
Address Wichita, Kansas

STATE OF Kansas, COUNTY OF Sedgwick, ss.

(employee of owner) or (owner or operator) of the above-described well, being first duly sworn on oath, says: That I have knowledge of the facts, statements, and matters herein contained and the log of the above-described well as filed and that the same are true and correct. So help me God.

(Signature) [Signature]
301 S. Market, Wichita 2, Kansas
(Address)

SUBSCRIBED AND SWORN TO before me this 27th day of March, 19 61
[Signature]
Notary Public.

My commission expires July 21, 1962

LARIO OIL & GAS COMPANY
 Stumph No. 1
 Cen. SE NW Sec. 13-22S-15W
 Barber County, Kansas

Drilling Commenced: March 4, 1961
 Drilling Completed: March 23, 1961
 Well Completed: March 23, 1961
 Drilling Contractor: Prime Drilling Company
 Total Depth - 5048'
 I.P. - Dry & Abandoned

CASING RECORD:
 8 5/8" 323.20 (O.A.) Set @ 333'
 Cem. w/ 275 sacks

<u>Formation</u>	<u>Depth</u>
Sand	95
Red bed	345
Red bed & shells	630
Red bed & shale	1490
Shale & shells	2100
Lime & shale	2135
Lime	2895
Lime & shale	4025
Lime	4102
Lime & shale	4273
Lime	4771
Lime & shale	4790
Lime	4796
Lime & shale	4911
Shale	4921
Lime	4940
Lime & shale	4972
Lime	5032
Lime & sand	5048

GEOLOGICAL TOPS - R.B. MEAS.

Elevation	1997 K.B. 1995' D.
Elgin Zone	3921 (-1924)
Heebner Shale	4088 (-2091)
Douglas Sand Zone	4121 (-2124)
Lansing	4247 (-2250)
Marmaton-Massey Zone	4705 (-2708)
Mississippian Conglomerate	4754 (-2757)
Viola	4923 (-2926)
Simpson	5043 (-3046)
Rotary Total Depth	5048
Schlumberger Total Depth	5048

RECEIVED
 STATE CORPORATION COMMISSION
 MAR 30 1961
 3-30-61
 CONSERVATION DIVISION
 Wichita, Kansas