


STATE OF KANSAS
STATE CORPORATION COMMISSION

WELL PLUGGING RECORD

Give All Information Completely
Make Required Affidavit
Mail or Deliver Report to
Conservation Division
State Corporation Comm.
245 North Water
Wichita, KS 67202

Barber County, Sec. 20 Twp. 32S Rge. 15 E/W
Location as "NE/CNW $\frac{1}{4}$ SW $\frac{1}{4}$ " or footage from lines
SW SW NE
Lease Owner Assoc. Petr. Consultants & Presley Companies
Lease Name Marsh Ranch West Well No. 1
Office Address Suite 600 - One Main Place, Wichita, KS 67202
Character of Well (Completed as Oil, Gas or Dry Hole)
Dry Hole
Date Well completed March 13 1981
Application for plugging filed March 13 1981
Application for plugging approved March 13, 1981
Plugging commenced 3:00 a.m. 1981
Plugging completed 6:30 a.m. 1981
Reason for abandonment of well or producing formation
D & A

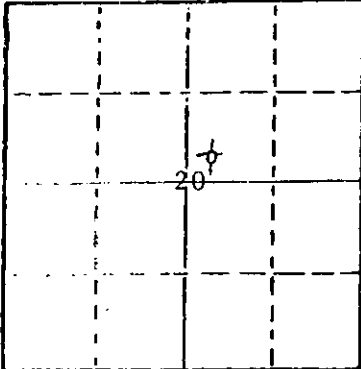

Locate well correctly on above
Section Plot

If a producing well is abandoned, date of last production
XXXX 19

Was permission obtained from the Conservation Division or
its agents before plugging was commenced?

Name of Conservation Agent who supervised plugging of this well Maurice Leslie, Nashville
Producing formation None Depth to top x Bottom x x Total Depth of Well 5360
Show depth and thickness of all water, oil and gas formations.

OIL, GAS OR WATER RECORDS

CASING RECORD

FORMATION	CONTENT	FROM	TO	SIZE	PUT IN	PULLED OUT
	275 sks. common-3% CC-2% Gel			8 5/8"	314'	None

Describe in detail the manner in which the well was plugged, indicating where the mud fluid
was placed and the method or methods used in introducing it into the hold. If cement or other
plugs were used, state the character of same and depth placed, from _____ feet to
_____ feet for each plug set.

Run Hole Full of Mud Run 40 sks cement at 310' - Mud to 40'
Bridge Plug and 10 sks cement to cellar
Spotted 10 sks in rat hole
Run 5 sks. in mouse hole

(If additional description is necessary, use BACK of this sheet)

Name of Plugging Contractor Trans-Pac Drilling, Inc.

STATE OF Kansas COUNTY OF Sedgwick, ss.
Phyllis Buchanan (employee of owner) or (owner or operator)

of the above-described well, being first duly sworn on oath, says: That I have knowledge of
the facts, statements, and matters herein contained and the log of the above-described well
as filed and that the same are true and correct. So help me God.

(Signature) Phyllis Buchanan Phyllis Buchanan
Wichita, Kansas
(Address)

SUBSCRIBED AND SWORN TO before me this 13th day of March, 1981

Jane Edwards
Notary Public
STATE CORPORATION COMMISSION

My commission expires 11/5/84

APR - 2 1981
4-2-81
CONSERVATION DIVISION
Wichita, Kansas