


WELL PLUGGING RECORD

Give All Information Completely
Make Required Affidavit
Mail or Deliver Report to:
Conservation Division
State Corporation Commission
212 North Market, Insurance Bldg.
Wichita, Kansas

Barber County, Sec. 11 Twp. 32S Rge. 15W (E) (W)
Location as "NE/CNW%SW%" or footage from lines SW SW NE
Lease Owner National Cooperative Refinery Association
Lease Name SKINNER "J" Well No. 1
Office Address 305 Rule Building, Wichita, Kansas
Character of Well (completed as Oil, Gas or Dry Hole) Dry Hole
Date well completed September 15 19 59
Application for plugging filed September 16 19 59
Application for plugging approved September 18 19 59
Plugging commenced September 15 19 59
Plugging completed September 15 19 59
Reason for abandonment of well or producing formation Dry Hole

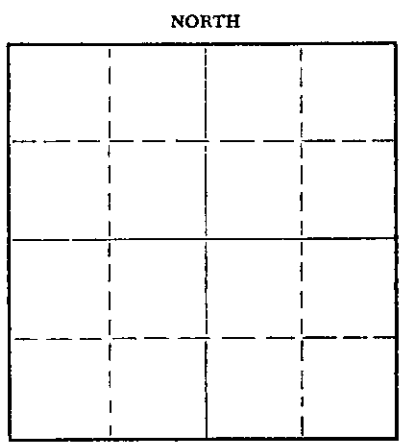

Locate well correctly on above Section Plot

If a producing well is abandoned, date of last production _____ 19____
Was permission obtained from the Conservation Division or its agents before plugging was commenced? Yes

Name of Conservation Agent who supervised plugging of this well John Broadfoot
Producing formation _____ Depth to top _____ Bottom _____ Total Depth of Well 4790 Feet
Show depth and thickness of all water, oil and gas formations.

OIL, GAS OR WATER RECORDS

CASING RECORD

FORMATION	CONTENT	FROM	TO	SIZE	PUT IN	PULLED OUT
				8-5/8"	317'	None-Cemented

Describe in detail the manner in which the well was plugged, indicating where the mud fluid was placed and the method or methods used in introducing it into the hole. If cement or other plugs were used, state the character of same and depth placed, from _____ feet to _____ feet for each plug set.

Mudded hole to 300 feet, set plug with 1/4 sack of hulls and 20 sacks of cement.
Mudded hole to 35 feet, set plug with 1/4 sack of hulls and 10 sacks of cement,
filled on up to base of cellar.

RECEIVED
STATE CORPORATION COMMISSION

OCT 22 1959
10-22-59
CONSERVATION DIVISION
Wichita, Kansas

(If additional description is necessary, use BACK of this sheet)
Name of Plugging Contractor Prime Drilling Company
Address 814 Union Center, Wichita, Kansas

STATE OF KANSAS, COUNTY OF SEDGWICK, ss.
C.R. SEARS (employee of owner) or (owner or operator) of the above-described well, being first duly sworn on oath, says: That I have knowledge of the facts, statements, and matters herein contained and the log of the above-described well as filed and that the same are true and correct. So help me God.

(Signature) C.R. Sears (C.R. Sears)
305 Rule Building, Wichita, Kansas (Address)

SUBSCRIBED AND SWORN TO before me this 21st day of October 19 59

My commission expires November 26, 1960
NELLE McCOMB Notary Public.

P
ROTARY DRILLING LOG

OPERATOR: National Cooperative Refinery Assn. SKINNER "J" #1
C SW SW NE Sec. 11-32S-15W,
Barber County, Kansas

CONTRACTOR: Prime Drilling Company
COMM: 8/30/59
COMP: 9/15/59

Formations:

Clay & Red Bed	35'
Sand	45'
Red Bed	317'
Red Bed & Shale	1080'
Red Bed	1340'
Red Bed, Shale & Shells	1715'
Shale & Shells	2130'
Shale & Lime	2185'
Lime	2545'
Sandy Lime	2605'
Lime & Shale Streaks	2730'
Lime & Shale	3200'
Shale & Lime	3395'
Lime & Shale	3785'
Lime	4066'
Lime & Sand	4125'
Sand & Lime Shale	4185'
Lime & Sand	4216'
Lime	4755'
Lime & Shale	4760'
Lime	4790'
Rotary Total Depth (D&A)	4790'

Remarks: Set 8-5/8" surface casing
at 317' cemented with 225
sacks cement

RECEIVED
STATE CORPORATION COMMISSION

OCT 22 1959
10-22-59
CONSERVATION DIVISION
Wichita, Kansas

We certify the above log is true and
correct to the best of our knowledge
and belief.

PRIME DRILLING COMPANY

R. R. McNicol
R. R. McNicol