

STATE OF KANSAS
STATE CORPORATION COMMISSION

Form CP-4

Give All Information Completely
Make Required Affidavit
Mail or Deliver Report to:
Conservation Division
State Corporation Commission
P. O. Box 17027
Wichita, Kansas 67217
NORTH


WELL PLUGGING RECORD

Harper County. Sec. 7 Twp. 32 Rge. 9 (E) W (W)
Location as "NE/CNW/SW" or footage from lines SE SW SW
Lease Owner Pickrell Drlg. Co.; Wichita, Ks. 67202
Lease Name Stone Well No. #1
Office Address 705 Fourth National Bank Building
Character of Well (completed as Oil, Gas or Dry Hole) Oil
Date well completed February 15 1972
Application for plugging filed August 25 1972
Application for plugging approved August 26 1972
Plugging commenced September 22 1972
Plugging completed September 26 1972
Reason for abandonment of well or producing formation Well Depleted

If a producing well is abandoned, date of last production January 26 1972
Was permission obtained from the Conservation Division or its agents before plugging was commenced? Yes

Name of Conservation Agent who supervised plugging of this well Russell Biberstein
Producing formation Mississippian Depth to top 4338 Bottom 4360 Total Depth of Well 4360 Feet

Show depth and thickness of all water, oil and gas formations.

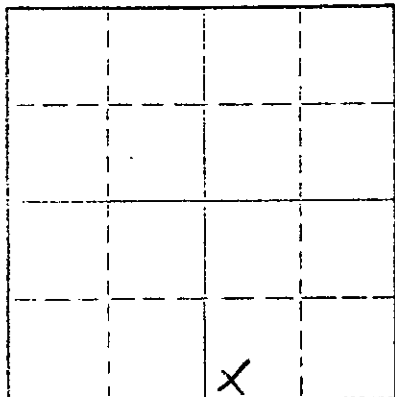

Locate well correctly on above Section Plat

OIL, GAS OR WATER RECORDS

CASING RECORD

FORMATION	CONTENT	FROM	TO	SIZE	PUT IN	PULLED OUT
				8 5/8"	200	None
				5 1/2"	4349	3655

Describe in detail the manner in which the well was plugged, indicating where the mud fluid was placed and the method or methods used in introducing it into the hole. If cement or other plugs were used, state the character of same and depth placed, from _____ feet to _____ feet for each plug set.

September 22, 1972 Plugged off bottom. Dumped sand to 4300'.
Mixed and dumped 5 sx of cement.

September 26, 1972 Plugged off top. Set 10' rock bridge at 240'.
Filled 8 5/8" surface casing from 240' to base
of cellar with 3000 lb. P.S.I. ready mix concrete.

RECEIVED
STATE CORPORATION COMMISSION
10-19-72
CONSERVATION DIVISION
Wichita, Kansas

(If additional description is necessary, use BACK of this sheet)

Name of Plugging Contractor RUSS CASING PULLING, INC.
Address P. O. Box 1082 ; Great Bend, Kansas 67530

STATE OF Kansas COUNTY OF Sedgwick, ss.
Dale M. Robinson (employee of owner) or (owner or operator) of the above-described

well, being first duly sworn on oath, says: That I have knowledge of the facts, statements, and matters herein contained and the log of the above-described well as filed and that the same are true and correct. So help me God.

(Signature) Dale M. Robinson
705 Fourth National Bank Bldg., Wichita, Kansas
(Address)

Subscribed and sworn to before me this 18th day of October, 19 72

January 19, 1973

Esther Lamone
Notary Public.

15-077-00221-0000
ROTARY DRILLING LOG

COMPANY: Pickrell Drilling Company, etal
 705 Fourth Nat'l Bank Bldg., Wichita, Kansas

Rotary Drilling Commenced 2/23/56

Rotary Drilling Completed 2/6/56

LOCATION: Stone A-1, 34 SW 34, Sec. 7-325-9W
 Harper County, Kansas

CONTRACTOR: PICKRELL DRILLING COMPANY
 Wichita, Kansas

CASING RECORD:

200' 8 5/8" Spiralweld casing 22.7" set at 200'
 with 150 sacks cement circulated (5 Jts)

133 Jts 5 1/2" 11# J-55 Cals casing set at 1349'
 with 100 sacks cement

LOG

(Figures indicate bottom of formation - measurements from top of rotary bushing.)

Sand & clay	45	Circ. for samples at	1250
Red Rock	200		1348
Red bed & shale	1385		1360
Shale & shells	1575		
Limo & shale	1735		
Lime	1860		
Shale & shells	2010		
Lime & shale	2120	Slope test at 2500 -	0° off
Shale & shells	2550	Slope test at 3550 -	0° off
Shale & Lime	2695	Slope test at 1348 -	0° off
Limo	3020		
Limo & shale	3176	S.L.M. at 2500 -	O.K.
Lime	3204	S.L.M. at 3550 -	O.K.
Limo & shale	3360	S.L.M. at 1348 -	O.K.
Lime	3657		
Limo & shale	3645		
Limo	4346		
Mississippi	4360	END	

RECEIVED
 STATE CORPORATION COMMISSION
 AUG 28 1972
 8-28-72
 CONSERVATION DIVISION
 Wichita, Kansas

The undersigned, _____, Attorney-in-Fact for PICKRELL DRILLING COMPANY, hereby certifies in behalf of said Company, that the above is a true and correct log of the formation encountered in drilling the above well as reflected by the Daily Drilling Reports.

PICKRELL DRILLING COMPANY
 By _____
 Attorney-in-Fact

STATE OF KANSAS, }
 COUNTY OF SEDGWICK } ss.:

On this 27th day of February, 1956, before me the undersigned, a Notary Public, in and for the County and State aforesaid, personally appeared _____, to me known to be the identical person who subscribed the name of PICKRELL DRILLING COMPANY to the foregoing instrument as its Attorney-in-Fact and acknowledged to me that he executed the same as his free and voluntary act and deed, and as the free and voluntary act and deed of such company, for the uses and purposes therein set forth.

Given under my hand and seal of office the day and year last above written.

My commission expires: July 23, 1958

 Notary Public