


STATE OF KANSAS
STATE CORPORATION COMMISSION

Form CP-4

Give All Information Completely
Make Required Affidavit
Mail or Deliver Report to:
Conservation Division
State Corporation Commission
P. O. Box 17027
Wichita, Kansas 67217
NORTH

WELL PLUGGING RECORD

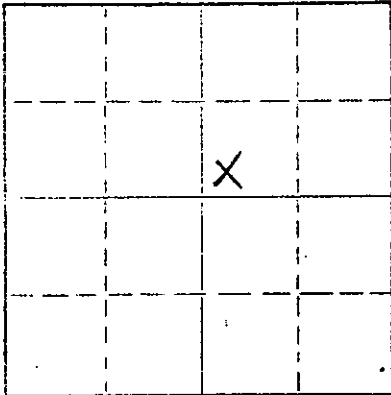

Locate well correctly on above
Section Plat

Barber County, Sec. 11 Twp. 32 Rge. 15 (E) W (W)
Location as "NE/CNWXSW" or footage from lines. SW SW NE
Lease Owner Walters Drilling Co.
Lease Name Skinner S.W.D. 'Y' Well No. 2
Office Address 400 Ins. Bldg. ; Wichita, Ks. 67202
Character of Well (completed as Oil, Gas or Dry Hole) Dry Hole
Date well completed September 18 1959
Application for plugging filed December 4 1972
Application for plugging approved December 5 1972
Plugging commenced December 29 1972
Plugging completed January 2 1973
Reason for abandonment of well or producing formation Oil production depleted all wells served by this SWD.
If a producing well is abandoned, date of last production 19____
Was permission obtained from the Conservation Division or its agents before plugging was commenced? Yes

Name of Conservation Agent who supervised plugging of this well Russell Biberstein
Producing formation _____ Depth to top _____ Bottom _____ Total Depth of Well 5311 Feet
Show depth and thickness of all water, oil and gas formations.

OIL, GAS OR WATER RECORDS

CASING RECORD

FORMATION	CONTENT	FROM	TO	SIZE	PUT IN	PULLED OUT
				8 5/8"	317	None
				5 1/2"	5205	791

Describe in detail the manner in which the well was plugged, indicating where the mud fluid was placed and the method or methods used in introducing it into the hole. If cement or other plugs were used, state the character of same and depth placed, from _____ feet to _____ feet for each plug set.

December 28, 1972 Plugged off bottom. Dumped sand to 4000'. Mixed and dumped 5 sx of cement.
January 2, 1973 Plugged off top. Set 10' rock bridge at 360'. Filled from 360' to base of cellar with 3000 lb. P.S.I. ready-mix concrete.

RECEIVED
STATE CORPORATION COMMISSION
JAN 10 1973
1-10-73
CONSERVATION DIVISION
Wichita, Kansas

(If additional description is necessary, use BACK of this sheet)

Name of Plugging Contractor RUSS CASING PULLING, INC.
Address P. O. Box 1082 ; Great Bend, Kansas 67530

STATE OF KANSAS COUNTY OF SEDGWICK, ss.

Robert F. Walters, Mng. Part. Walters Drilling Co. (employee of owner) or (owner or operator) of the above-described well, being first duly sworn on oath, says: That I have knowledge of the facts, statements, and matters herein contained and the log of the above-described well as filed and that the same are true and correct. So help me God.

(Signature)

Robert F. Walters
400 Insurance Building, Wichita, Kansas 67202

(Address)

Subscribed and sworn to before me this 8th day of January, 1973

My commission expires June 10, 1973

Ruth Every

Notary Public.

ROTARY DRILLING LOG

Operator: Aylward Drilling Company
 Skinner "Y" #2 (OWDD)
 SW SW NE Section 11-32-15W
 Barber County, Kansas

Contractor: Aylward Drilling Company
 Commenced: November 4, 1965
 Completed: November 14, 1965
 Elevation: 1968 K.B.

Formations	From	To	Remarks
			Set 5½" casing @ 5205' w/75 sax cement.
			Formation Tops:
Shale	4790-	4828	Maquoketa 4917
Shaly, Limestone	4828	4882	Viola 4933
Shale	4882	4917	Simpson Sandstone 5066
Dolomite	4917	5066	Arbuckle 5189
Sandstone	5066	5115	
Shale	5115	5189	
Dolomite	5189	5311	
Rotary Total Depth		5311	

RECEIVED
 STATE CORPORATION COMMISSION
 DEC 6 - 1972
 12-6-72
 CONSERVATION DIVISION
 Wichita, Kansas

I hereby certify that this is a true and correct copy of the above log to the best of my knowledge.

Frank A. Hamlin

Subscribed and sworn to before me this 6th day of December, 1965

Joseph A. Hass

Notary Public

My commission expires May 14, 1968