

STATE OF KANSAS
STATE CORPORATION COMMISSION


WELL PLUGGING RECORD

Give All Information Completely
Make Required Affidavit
Mail or Deliver Report to:
Conservation Division
State Corporation Commission
212 North Market, Insurance Bldg.
Wichita, Kansas

Barber County, Sec. 11 Twp. 32S Rge. 15W (EX) (W)

Location as "NE/CNW&SW" or footage from lines C SE SW
Lease Owner Ferguson Oil Company, Inc.
Lease Name Skinner Well No. B-1
Office Address 2700 Liberty Tower; Oklahoma City, Oklahoma 73102
Character of Well (completed as Oil, Gas or Dry Hole) Oil
Date well completed June 3 19 65
Application for plugging filed May 22 19 72
Application for plugging approved May 22 19 72
Plugging commenced May 22 19 72
Plugging completed May 27 19 72
Reason for abandonment of well or producing formation Production decline -
Uneconomical
If a producing well is abandoned, date of last production March 11 19 72
Was permission obtained from the Conservation Division or its agents before plugging was commenced? Yes

NORTH

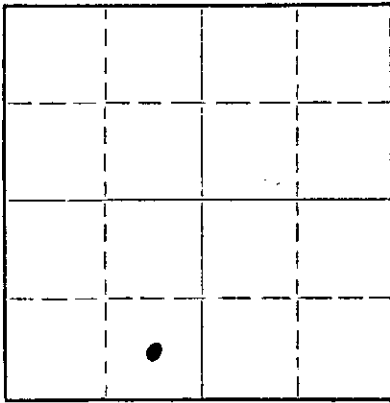

Locate well correctly on above Section Plat

Name of Conservation Agent who supervised plugging of this well Russell Biberstein
Producing formation Viola Depth to top 4960' Bottom Total Depth of Well 5067 Feet
Show depth and thickness of all water, oil and gas formations.

OIL, GAS OR WATER RECORDS

CASING RECORD

FORMATION	CONTENT	FROM	TO	SIZE	PUT IN	PULLED OUT
				8 5/8"	217'	None
				5 1/2"	5050'	1694'

Describe in detail the manner in which the well was plugged, indicating where the mud fluid was placed and the method or methods used in introducing it into the hole. If cement or other plugs were used, state the character of same and depth placed, from feet to feet for each plug set.
Sand from: 4977' to 4727'
Cement 5 sacks from 4727' to 4690'
Ripped pipe at 3800', 3500', 3000', 2500', 2000', 1700'
Build bridge at 215', then rock from 215' to 205'; dumped 3 yds. of Ready-Mix cement.

RECEIVED
STATE CORPORATION COMMISSION
JUN 26 1972
6-26-72
CONSERVATION DIVISION
Wichita, Kansas

(If additional description is necessary, use BACK of this sheet)

Name of Plugging Contractor Clarke Corporation
Address P. O. Box 187; Medicine Lodge, Kansas

STATE OF Oklahoma, COUNTY OF Oklahoma, ss.
W. D. Stancliffe

(employee of owner) or (owner) of the above-described well, being first duly sworn on oath, says: That I have knowledge of the facts, statements, and matters herein contained and the log of the above-described well as filed and that the same are true and correct. So help me God.

(Signature) W. D. Stancliffe, Vice-President
2700 Liberty Tower; Oklahoma City, Okla. 73102
(Address)

SUBSCRIBED AND SWORN TO before me this 8th day of June, 19 72

My commission expires 2/2/76

Janine Walker
Notary Public.

DRILLER'S LOG

COMPANY: Ferguson Oil Company et al
1505 Wichita Plaza Building
Wichita, Kansas

WELL NAME: Skinner "B" #1
C SE SW Section 11-32S-15W
Barber County, Kansas

CONTRACTOR: Walters Drilling Co.
510 Orpheum Building
Wichita, Kansas

ROTARY DRILLING COMMENCED: May 18, 1965
ROTARY DRILLING COMPLETED: June 3, 1965

ELEVATION: 2026 KB

CASING RECORD: 8 5/8" set @ 217' w/ 170 sacks cement

LOG

0 - 45	Sand
45 - 110	Sand and Shale
110 - 960	Shale and Red Bed
960 - 1080	Shale
1080 - 1205	Shale
1205 - 1610	Shale and Shells
1610 - 2050	Shale - L. Streaks
2050 - 2235	Shale and Shells
2235 - 2380	Shale and Lime
2380 - 2770	Lime and Shale
2770 - 2905	Lime and Shale
2905 - 3285	Shale and Lime
3285 - 3435	Shale - Lime Streaks
3435 - 3640	Shale
3640 - 3865	Shale and Lime
3865 - 4068	Shale
4068 - 4182	Shale and Shells
4182 - 4320	Shale and Lime
4320 - 4355	Lime
4355 - 4460	Brown Lime
4460 - 4714	Lime
4714 - 4750	Lime and Shale
4750 - 5067	Lime
<u>5067</u>	<u>Rotary Total Depth</u>

RECEIVED
STATE CORPORATION COMMISSION
JUN 26 1972
6-26-72
CONSERVATION DIVISION
Wichita, Kansas

The undersigned, Robert F. Walters, hereby certifies, in behalf of said company that the above log is a true and correct log of the formations encountered in drilling the above well as reflected by the Daily Drilling Reports.

WALTERS DRILLING CO.

BY

Robert F. Walters
ROBERT F. WALTERS, Partner

Subscribed and sworn to before me
this 8th day of June, 1965.

Juana M. Green
Juana M. Green, Notary Public

My Commission Expires: October 4, 1967