


STATE OF KANSAS  
STATE CORPORATION COMMISSION  
Give All Information Completely  
Make Required Affidavit  
Mail or Deliver Report to:  
Conservation Division  
State Corporation Commission  
211 No. Broadway  
Wichita, Kansas

WELL PLUGGING RECORD

Barber County, Sec. 12 Twp. 32 Rge. (E) 15 (W)

Location as "NE/CNW/SW" or footage from lines SE SE NE  
Lease Owner National Cooperative Refinery Association  
Lease Name Stumph-Smith "D" Well No. 1  
Office Address P. O. Box #6, Great Bend, Kansas 67530  
Character of Well (completed as Oil, Gas or Dry Hole) Oil  
Date well completed May 1, 19 57  
Application for plugging filed December 21, 19 66  
Application for plugging approved December 22, 19 66  
Plugging commenced January 9, 19 67  
Plugging completed January 16, 19 67  
Reason for abandonment of well or producing formation Depleted

NORTH

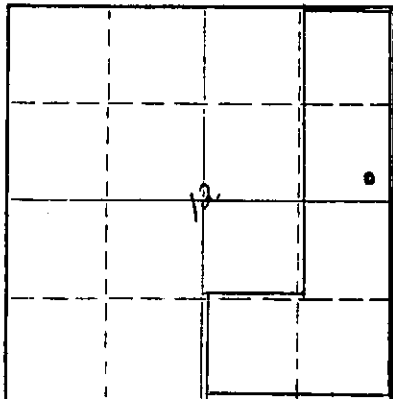

Locate well correctly on above Section Plat

If a producing well is abandoned, date of last production December 26, 19 66  
Was permission obtained from the Conservation Division or its agents before plugging was commenced? Yes

Name of Conservation Agent who supervised plugging of this well Archie Elving  
Producing formation Simpson Sand Depth to top 4958 Bottom 4961 Total Depth of Well 4961 Feet  
Show depth and thickness of all water, oil and gas formations.

OIL, GAS OR WATER RECORDS

CASING RECORD

FORMATION	CONTENT	FROM	TO	SIZE	PUT IN	PULLED OUT
				8 5/8"	241'	None
				5 1/2"	4959.5'	3817'

Describe in detail the manner in which the well was plugged, indicating where the mud fluid was placed and the method or methods used in introducing it into the hole. If cement or other plugs were used, state the character of same and depth placed, from feet to feet for each plug set.

Sanded hole from 4963' to 4950', dumped 5 sxs. cem. Pulled 3817' 5 1/2" csg. Mudded hole to 235', set 10' rock bridge to 225', dumped 3 1/2 yards ready mix cement on up to base of cellar.

RECEIVED  
STATE CORPORATION COMMISSION

JAN 20 1967

1-20-67

CONSERVATION DIVISION  
Wichita, Kansas

Name of Plugging Contractor Ralph Comstock  
Address 320 North Park, Stafford, Kansas

STATE OF KANSAS, COUNTY OF BARTON, ss.  
Joe Hertel (employee of owner) or (agent of operator) of the above-described well, being first duly sworn on oath, says: That I have knowledge of the facts, statements, and matters herein contained and the log of the above-described well as filed and that the same are true and correct. So help me God.

(Signature) Joe Hertel  
Joe Hertel  
Box 6, Great Bend, Kansas 67530 (Address)

SUBSCRIBED AND SWORN TO before me this 19th day of January, 19 67

My commission expires October 23, 1970

Irene Kelly Marney  
Notary Public.